Name

Service No.

Address 222 Concord Avenue

Location


Repair Renewal- New Service

Date	Material	Amount	Total	Date	Amount
Sep. 2022	1" K Copper				
	1" Curb Stop				
	1" Curb Stop open-night				
	Buffalo Box				
					-

Date: Sep, 2022

TOWN OF LEXINGTON - BOARD OF PUBLIC WORKS WATER DIVISON

SKETCH OF SERVICE HERE

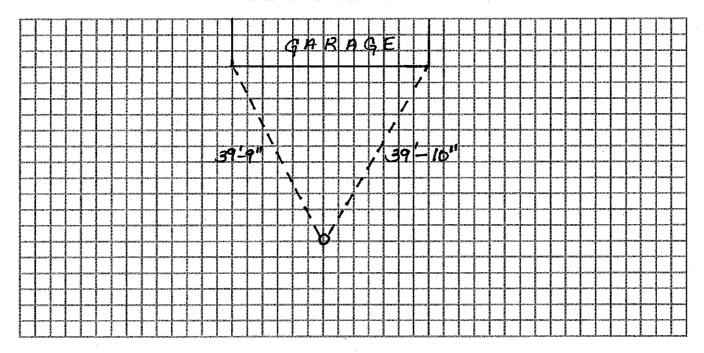

Connection made in:	Street.	Work completed:
Remarks: Installed by Jovino E	Excavating	