

WATER SERVICE RECORD

4281

Service No. 363

Name Frank E. Dea

Address 225 Oceanic Ave.

1703

Location

Repair—Renewal—New Service

Com. 11-30-53


Date	Material	Amount	Total	Date	Amount
11/8/53	Labor	24 60		11-18-53	75 00
	10% Overhead	2 46	27 06	11-30-53	19 40
	58' - 3/4" Copper tubing	33 29	13 79	<i>Deposited</i>	
	1 - 3/4" Galv. I.W.R. stop & waste	4 00		<i>Refunded</i>	
	2 hrs. turn shovel	5 00	10 00	NON CHARGE	
	1 hr. trucking		75	SERVICE IN TO CURB:	
			55 60		1 00
3/11/53	30' 3/4" Copper				
	1 3/4" CORP.				
	1 3/4" CURB				
	1 Box + Rod				

DATE _____

TOWN OF LEXINGTON — BOARD OF PUBLIC WORKS

WATER DIVISION

Sketch of Service Here

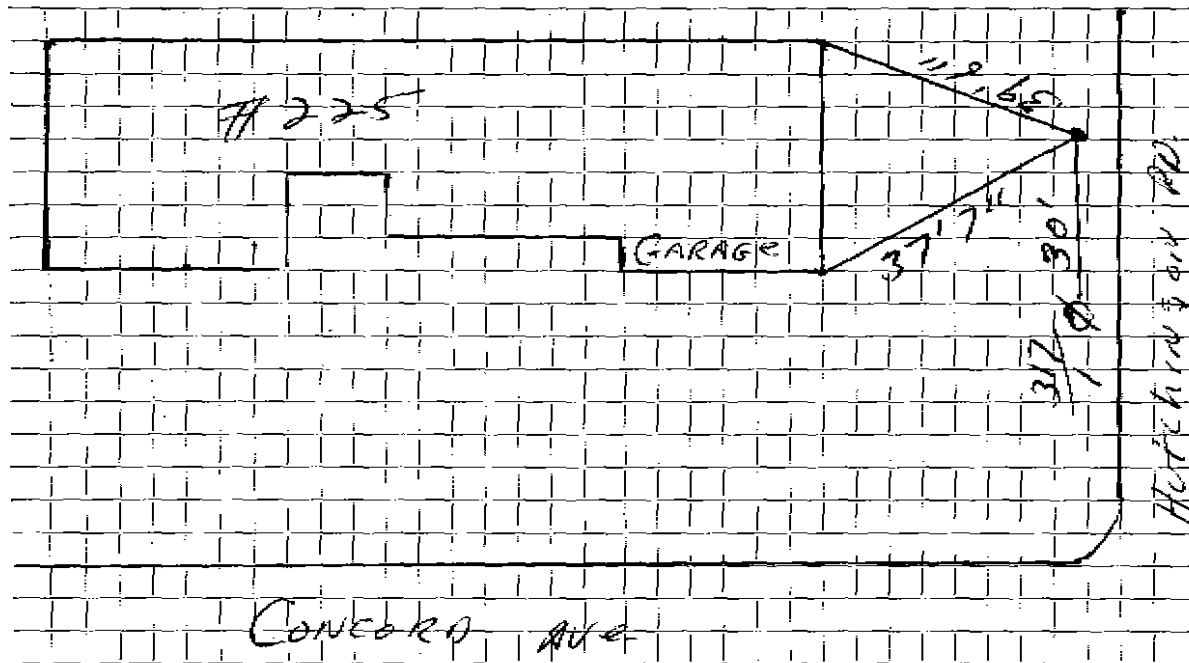

Connection made in Street. Work completed

Remarks:

.....
.....