

## WATER SERVICE RECORD

Name

Service No.

Address 234 Concord Ave.

Location


Repair—Renewal—New Service Change from 6" to 12" Main

Date	Material	Amount	Total	Date	Amount
8/6/47				8/6/47	3/4 COPPER
48	3/4 COPPER			1	3/4 CURB STOP
1	3/4 x 1/2 S & W				Box + Rod
1 LB	DYNAMITE				OUTSIDE
				8/9/74	1 3/4" Corp.
				1/2	Ton Cold Patch
				3	Hours Trucking
				2	Hours Backhoe
				1/2	Hour Compressor
				1/2	Hour Loader

DATE \_\_\_\_\_

**TOWN OF LEXINGTON — BOARD OF PUBLIC WORKS**  
**WATER DIVISION**

Sketch of Service Here

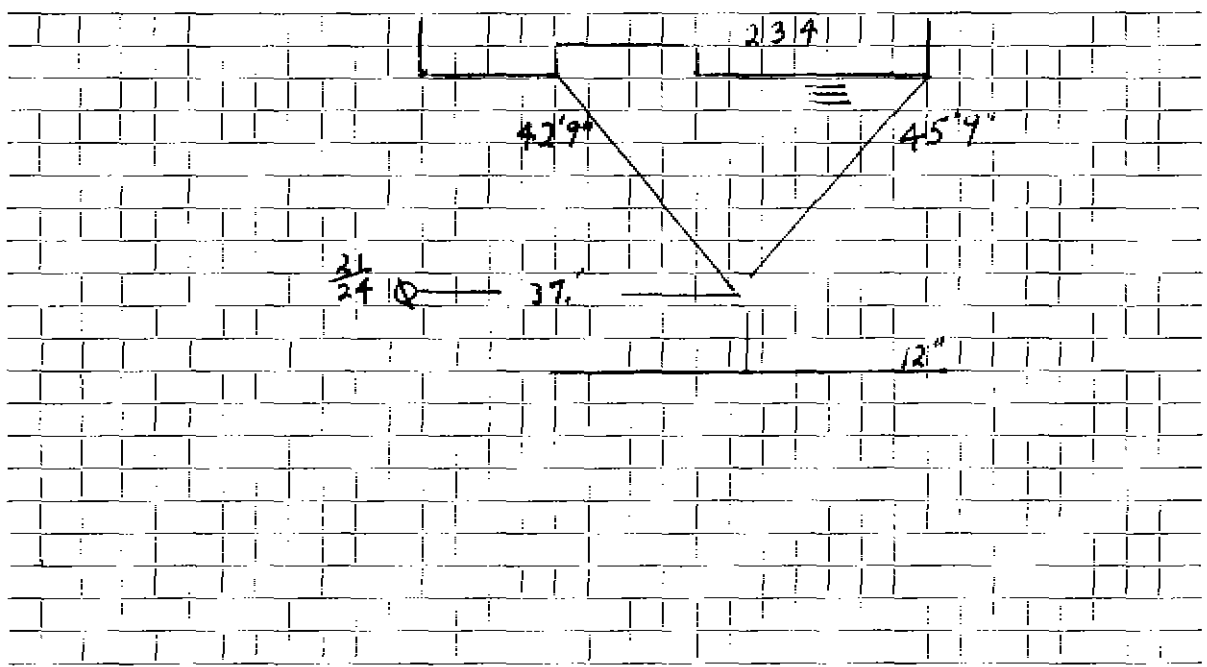

Connection made in ..... Street. Work completed .....

Remarks: .....  
.....  
.....