

WATER SERVICE RECORD

Name

Service No.

Address 235 Concord Ave.

Location

Repair—Renewal—New Service Change from 6" to 12" Main


Date	Material	Amount	Total	Date	Amount
5/18/53	42' 3/4 COPPER			5/18/53	3/4 COPPER
	1 3/4 x 1/2 S+W				1 3/4 Coub
					Box + Rod
					OUTSIDE
				8/29/74	1 Hour Trucking
					1/2 Hour Compressor
					1/2 Hour Loader
					1 3/4 COPP
					3/4 COPPER

DATE _____

TOWN OF LEXINGTON — BOARD OF PUBLIC WORKS

WATER DIVISION

Sketch of Service Here

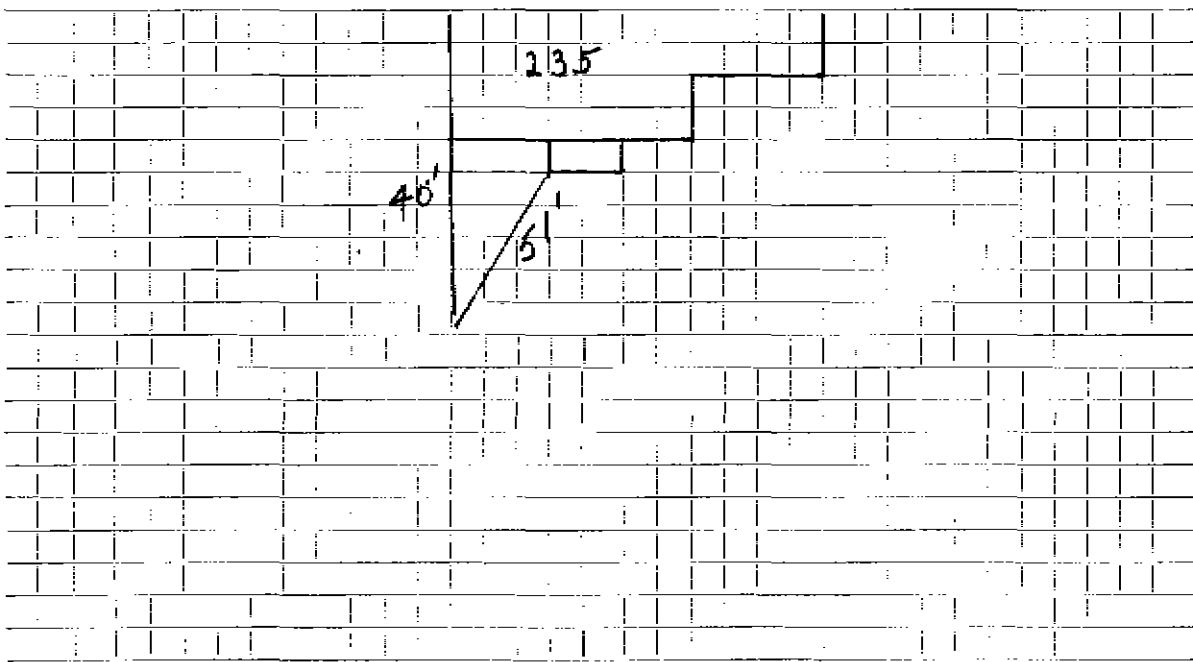

Connection made in Street. Work completed

Remarks:
.....
.....