

WATER SERVICE RECORD

Name Highland Bldg., Inc.

Service No. 95

Address 239 Concord Ave.

Location Lexington

~~Repair~~ ~~Renewal~~ New Service COM. 6-8-53


Date	Material	Amount	Total	Date	Amount
5/19/53	Labor	6.37		5-14-53 Deposited	65.00
	10% overhead	64	7.01	6-17-53 Refunded	(20.96)
	42' - 3/4" copper tubing @ .34	14.28			NON CHARGE
	2 hrs. Littlefield shovel @ 7.50	15.00		5/19/53 Labor	6.38
	1-3/4" G x 1/2" I.W.H. stop & waste	4.00		10' - 3/4" Copper tubing @ .34	3.40
	1 hr. trucking		75	1-3/4" G corp-cock	4.33
	patching 3 x 3		3.00	1-3/4" G x 3/4" G curb-cock	4.67
			144.04	1 box and rod	3.90
				1-1/2 offset tail piece	50
				1-1/2 straight tail piece	50
8/6/74	17' 3/4" copper			1 hr. Littlefield shovel	7.50
	1 3/4 corp.			1 hr. trucking	75
	1 3/4 UNION				31.93
Changed from 6" to 12" MAIN					

DATE _____

TOWN OF LEXINGTON — BOARD OF PUBLIC WORKS

WATER DIVISION

Sketch of Service Here

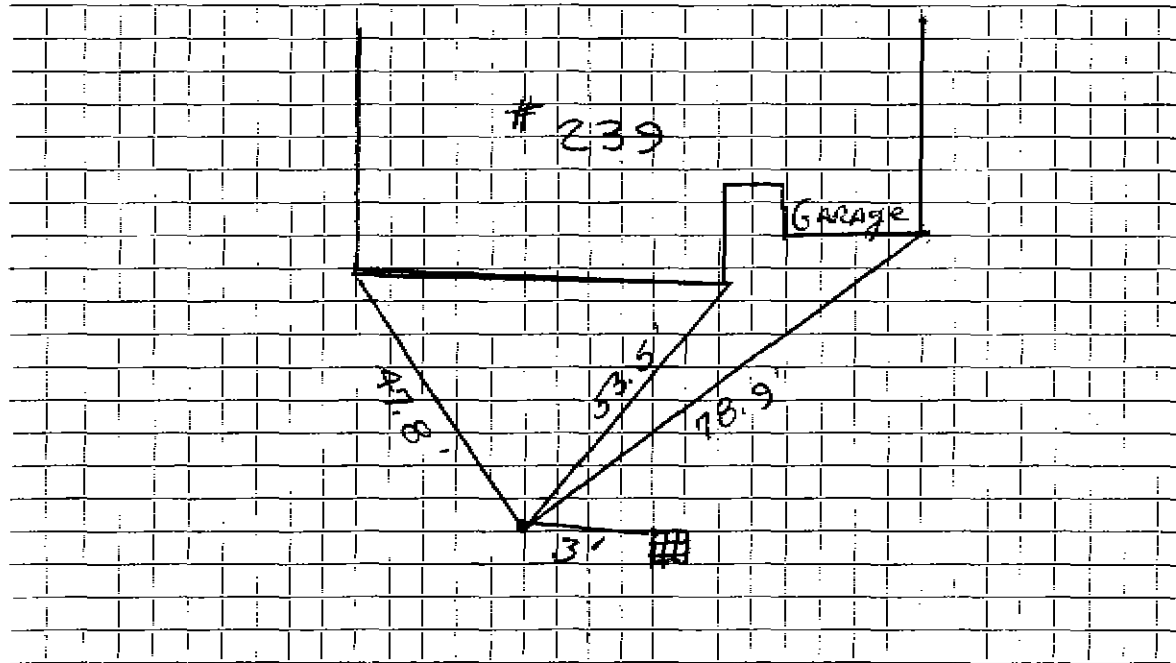

Connection made in Street. Work completed

Remarks:

.....

.....