


DATE _____

TOWN OF LEXINGTON — BOARD OF PUBLIC WORKS

WATER DIVISION

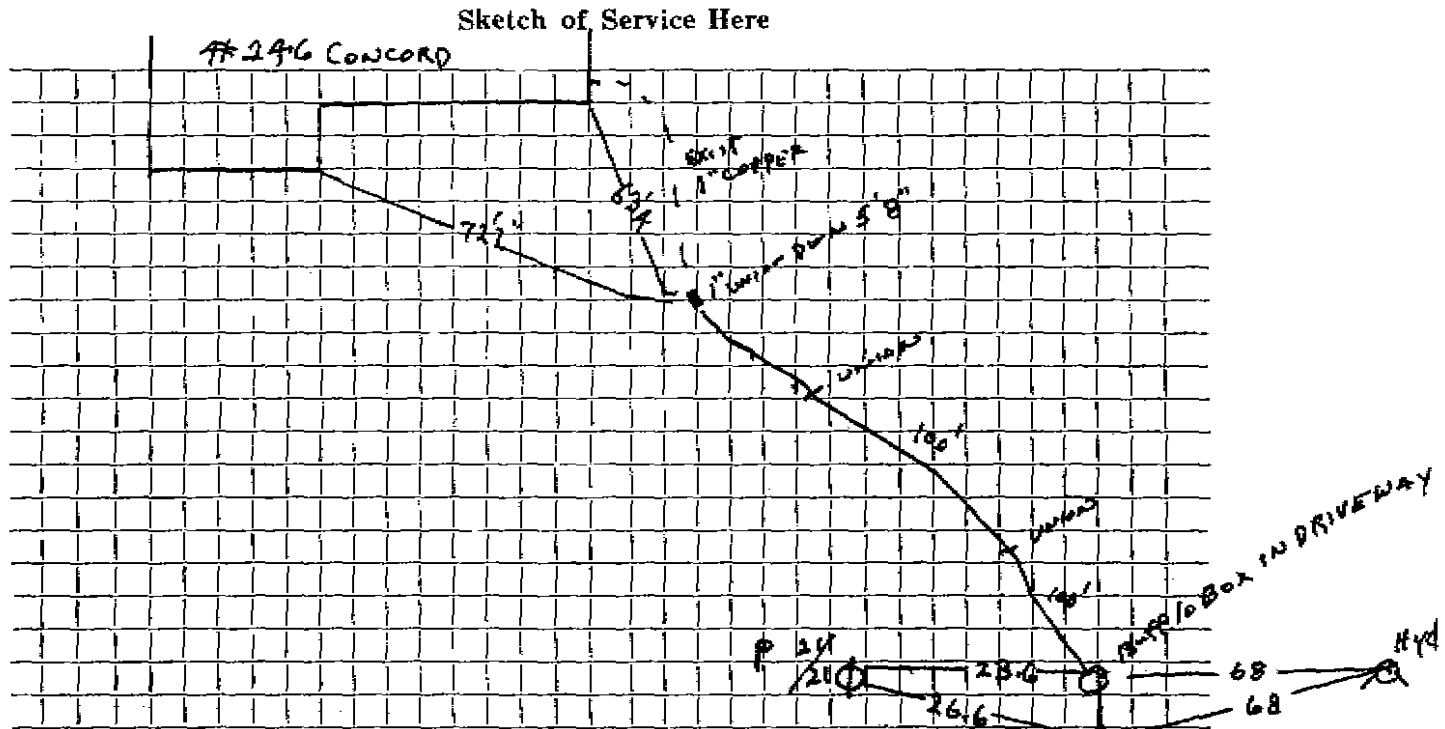

Connection made in CONCORD AVE Street.

Work completed 11/15/99 5' DOWN 12" MAIN

Remarks: INST. ON SAT. NOT INSP.

TAP G. MOSEY.

