

WATER SERVICE RECORD

70 11

Name Colonial Development Corp.

Service No. 15

Address 247 Concord Avenue

Location

Repair—Renewal—New Service *CHANGED TO 12" MAIN 1974* *Com m. 6-2-58*


Date	Material	Amount	Total	Date	Amount
3/6/58	Labor	11 50		2-10-58	<i>Deposit</i> \$ 100 00
3/7/58	"	13 03		6-2-58	<i>Refund</i> 20 88
		24 53			<i>\$ 79 12</i>
	10% overhead	2 45	26 98		NON CHARGE
	39' - 3/4" Copper tubing @ .37		14 43	3/7/58	Labor 6 29
	1 - 3/4" Cx 1/2 I.W.H. Stop & Waste		4 96		10' 3/4" Copper tubing @ .37 3 70
	3 1/2 hrs. Town Shovel @ 6.50		22 75		1 - 3/4" C. Corp Cock 4 64
	1 hr. Trucking		3 00		1 - 3/4" C. Curb Cock 5 94
	1 hr. Rodgers Trailer		3 00		1 Box & Rod 4 62
	Patch 4x3		4 00		1/2 hr. Town Shovel @ 6.50 3 25
			79 12		1 hr. Trucking 75
					<u>29 19</u>
			<i>2/7/74</i>	<i>14'</i>	<i>3/4 COPPER</i>
				<i>1</i>	<i>3/4 Union</i>
				<i>1</i>	<i>3/4 CORP</i>

DATE _____

TOWN OF LEXINGTON — BOARD OF PUBLIC WORKS

WATER DIVISION

Sketch of Service Here

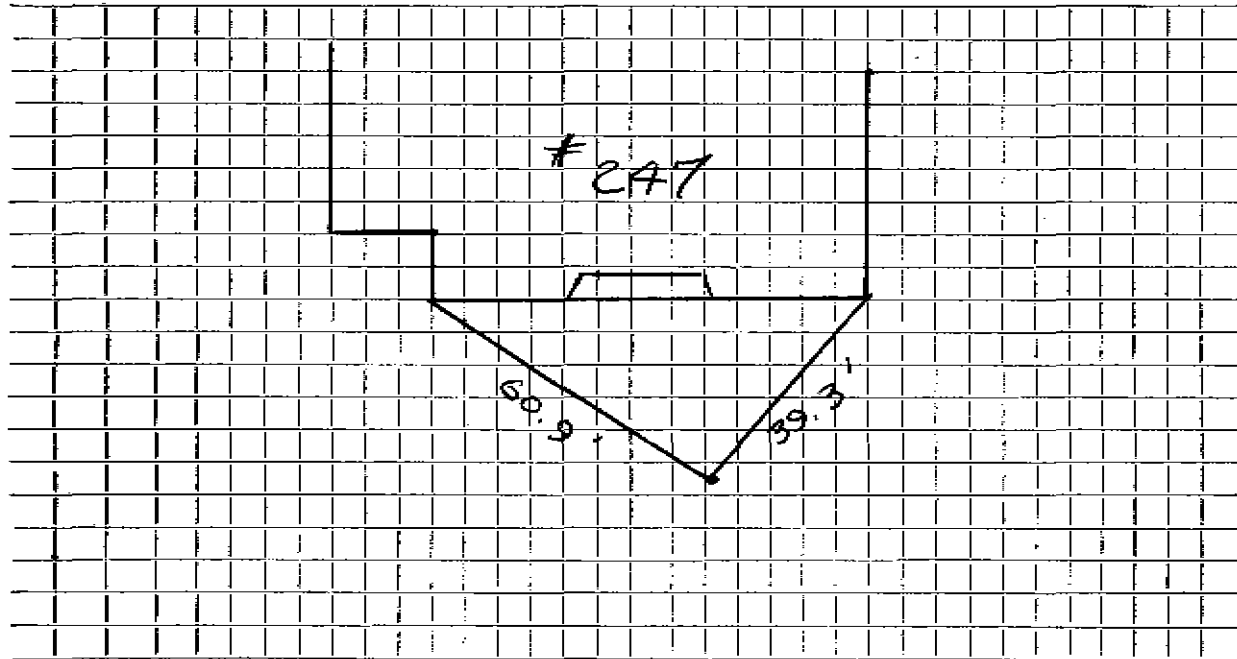

Connection made in Street. Work completed

Remarks:

.....

.....