

WATER SERVICE RECORD

Name Republican Building Corporation

Service No. 67

Address 250 Concord Avenue

Location

~~Repair~~ ~~Renewal~~ ~~New Service~~ Eagle #2797 W 3913

Date	Material	Amount	Total	Date	Amount
------	----------	--------	-------	------	--------

AUG 16 1976

5/14/76	60' 3/4" Copper Tubing			12-15-76	Deposit	150.00
				1-15-77	Refund	111.38
						48.62
					NON CHARGE	
				8-25-58	Labor	20.86
				12'	3/4" Copper tubing @.37	4.44
				1	3/4" C Corp Cock	4.64
				1	3/4" C Curb Cock	6.03
				1	Box & Rod	5.00
				1	hr. Town Shovel @6.50	6.50
				1	hr. Trucking @.75	.75
						48.22


** pay 55.57 to WHET 6/1*

DATE _____

TOWN OF LEXINGTON — BOARD OF PUBLIC WORKS

WATER DIVISION

Sketch of Service Here

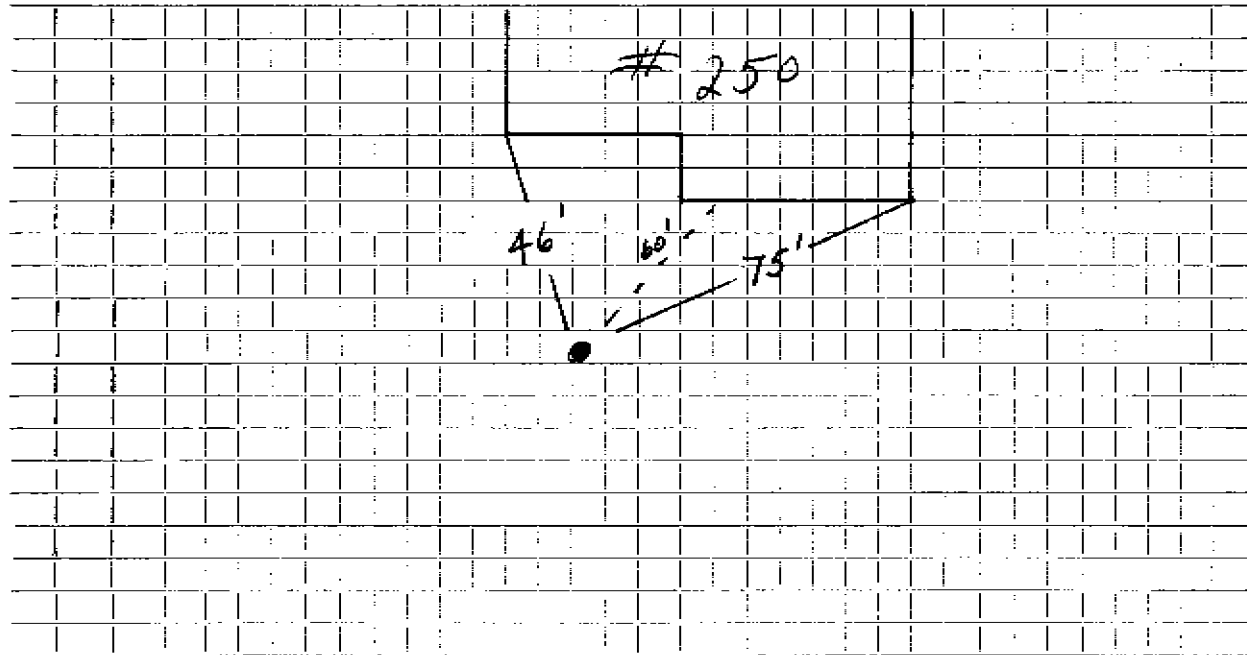

Connection made in Street. Work completed

Remarks:

.....

.....