

## WATER SERVICE RECORD

Name

Service No.

Address 253 Concord Ave.

Location

Repair—Renewal—New Service Change from 6" to 12" Main


Date	Material	Amount	Total	Date	Amount
10/1/40	43' 3/4 COPPER 1 3/4 x 1/2 S & W				
					OUTSIDE
				8/7/74	1 3/4" Corp.
					1 3/4" Union
					20' 3/4" Copper Pipe
					1/2 Ton Cold Patch
					3 Hours Trucking
					2 Hours Backhoe
					1/2 Hour Compressor
					1/2 Hour Loader

DATE \_\_\_\_\_

TOWN OF LEXINGTON — BOARD OF PUBLIC WORKS

**WATER DIVISION**

Sketch of Service Here

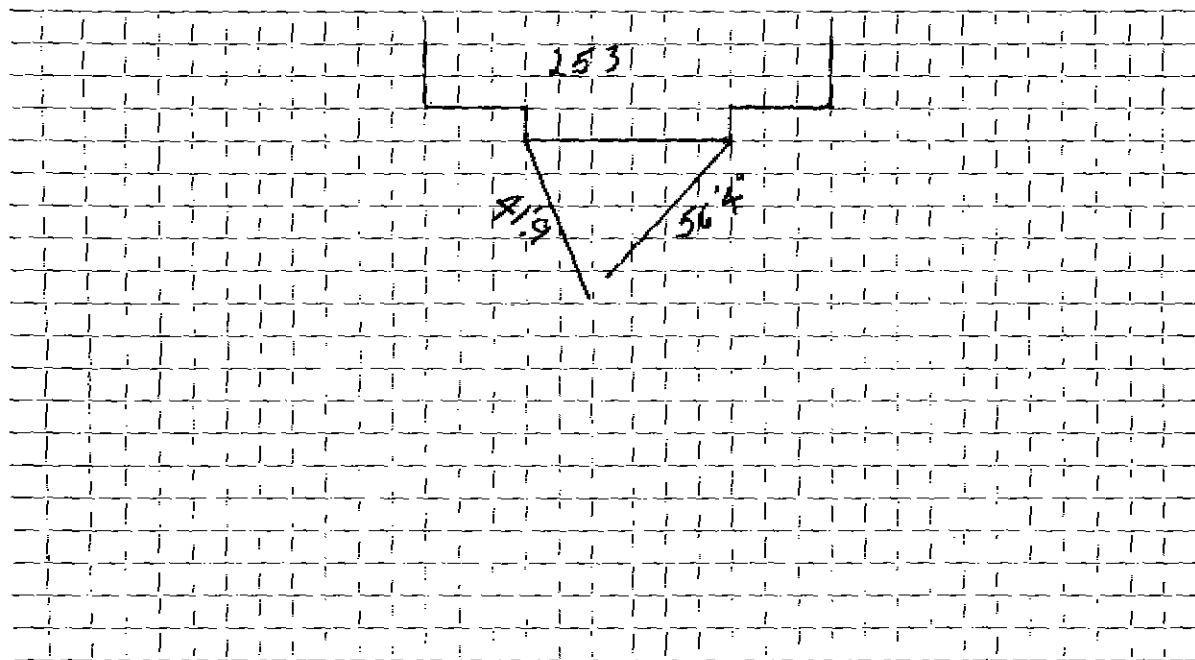

Connection made in ..... Street. Work completed .....

Remarks: .....

.....

.....