


DATE _____

TOWN OF LEXINGTON — BOARD OF PUBLIC WORKS

WATER DIVISION

260 CONCORD AVE (VACANT LOT) STA 51+60

Sketch of Service Here

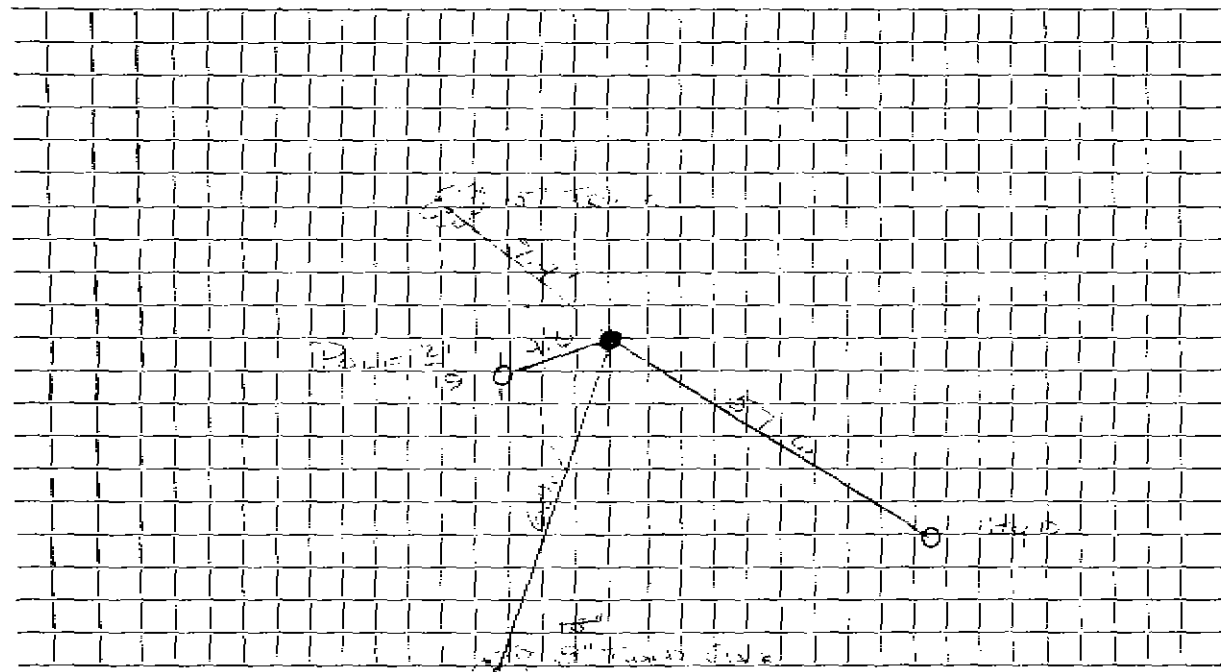

Connection made in Street. Work completed

Remarks:
.....
.....