

## WATER SERVICE RECORD

Name

Service No.

Address 267 Concord Ave.

Location

~~Repair~~ Renewal ~~New Service~~ WO #4365


change to 12" main

Date	Material	Amount	Total	Date	Amount
5/21/76	labor 5hr. 4 men				
	labor 5hr. police				
16'	3/4" Copper				
1	3/4" corp,				
2	tons cold patch				
1	3/4" Style 88				
2	hrs. trucking				
3	hrs. shovel				
6/9/78	41' 3/4 COPPER				
	1 3/4 x 1/2 S+W				

DATE \_\_\_\_\_

**TOWN OF LEXINGTON — BOARD OF PUBLIC WORKS**  
**WATER DIVISION**

Sketch of Service Here

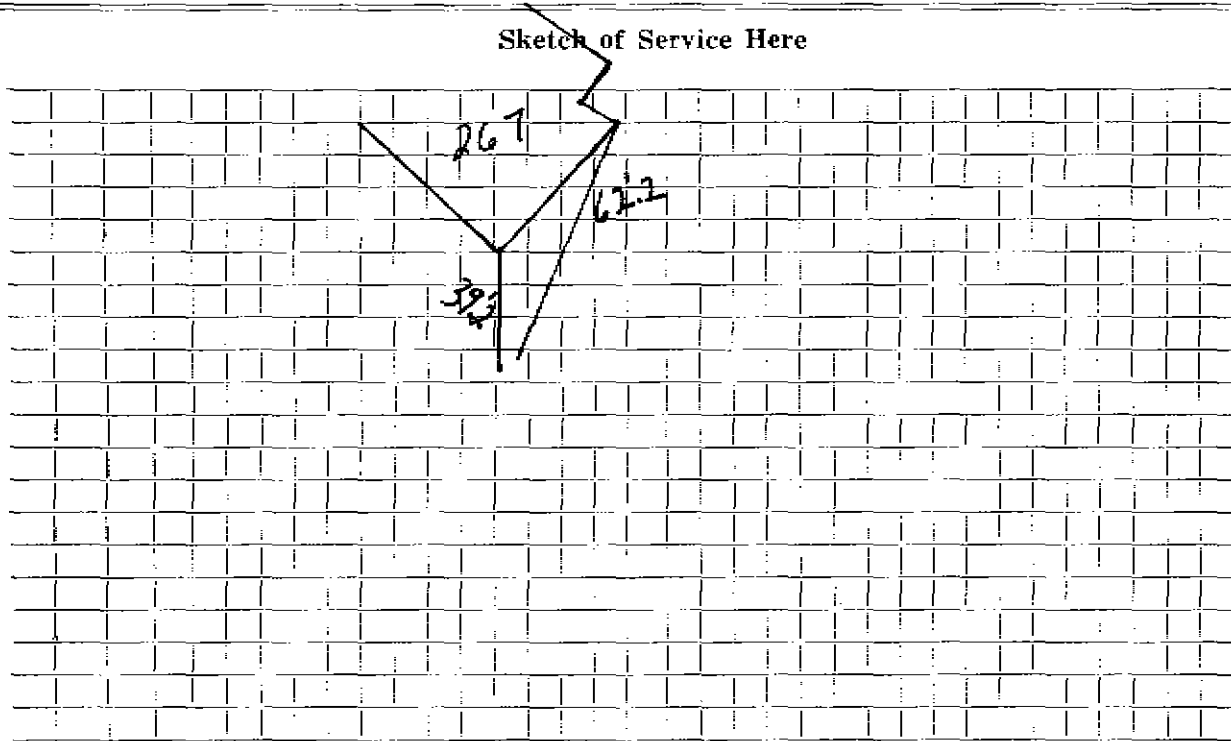

Connection made in ..... Street. Work completed .....

Remarks: .....

.....

.....