

WATER SERVICE RECORD

Name Harriett Babson

Service No. 213

Address 272 Concord Avenue

Location

~~WATER SERVICE~~ - New Service

Comd 8/15/55


Date	Material	Amount	Total	Date	Amount
7/8/55	Labor	42.42		7-5-55	200.00
	10% O.H.	4.24	46.66		41.30
125'	1" Copper tubing @ .4584		57.30		158.73
1	1" C x 1" I.W.H. Stop & Waste		4.50		NON CHARGE
2	1" C x 1" C Union @ 2.26		4.52	10-2-62	Labor 22.58
6	hrs. Littlefield Shovel @ 7.50		45.00	13'	1" Copper tubing @ .56 10.08
1	hr. Trucking		.75	1	1" C Corp Cock 7.31
			158.73	1	1" C Curb Cock 8.06
				1	Box & Rod 4.90
				2	hrs. Town Shovel @ 6.50 13.00
				1	hr. Trucking @ 3.00 3.00
					68.93

DATE _____

TOWN OF LEXINGTON — BOARD OF PUBLIC WORKS

WATER DIVISION

Sketch of Service Here

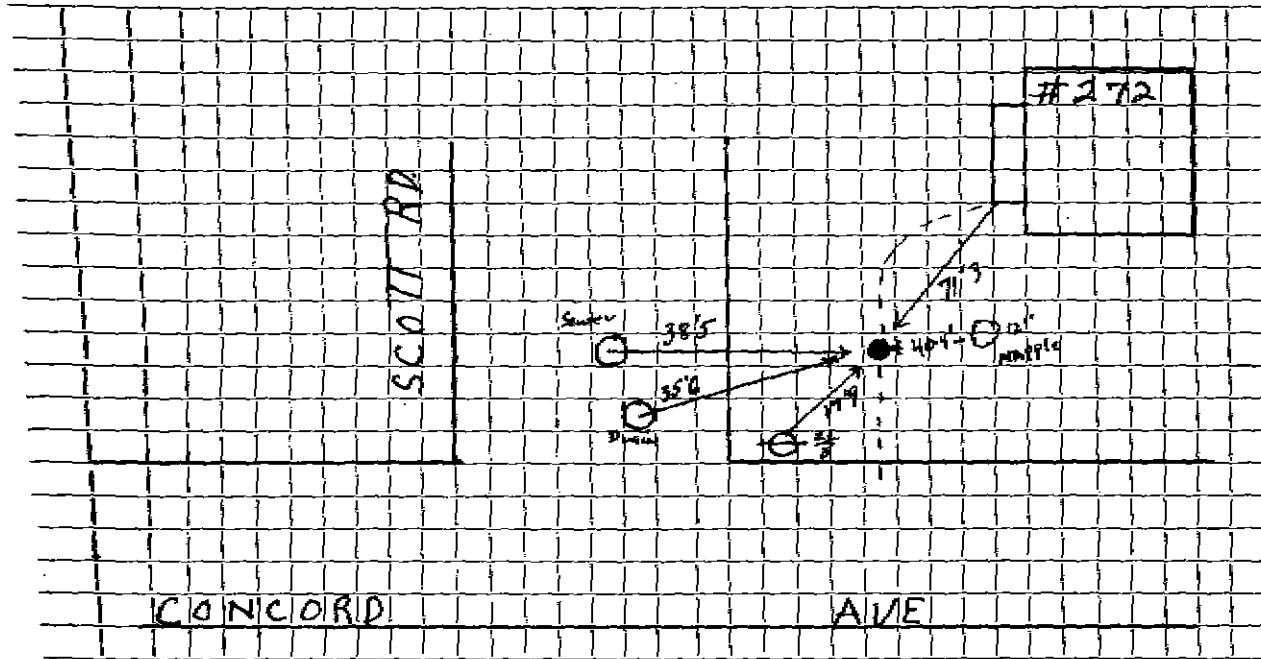

Connection made in _____ Street. Work completed _____

Remarks: _____

