

WATER SERVICE RECORD

Name

Service No.

Address 275 Concord Ave.

Location

~~Repair~~ - Renewal - ~~New Service~~ WO #4361

change to 12" main


| Date | Material | Amount | Total | Date | Amount |
|---------|---------------------|--------|-------|---------|----------------|
| 5/20/76 | labor 4 hr. 4 men | | | | |
| | labor 8 hr. police | | | | |
| | 24' 3/4" Copper | | | 9/23/48 | CHANGED TO 12" |
| | 1 3/4" Corp. | | | 8' 3/4" | COPPER |
| | 1 3/4" 3 part union | | | | 3/4 CURB STOP |
| | 4 tons cold patch | | | | BOX + ROD |
| | 1/2 roll insulation | | | | |
| | 2 hr. trucking | | | | |
| | 3 hr. shovel | | | | |
| 9/23/48 | 39' 3/4 COPPER | | | | |
| | 1 3/4x1/2 S+W | | | | |

DATE _____

TOWN OF LEXINGTON — BOARD OF PUBLIC WORKS

WATER DIVISION

Sketch of Service Here

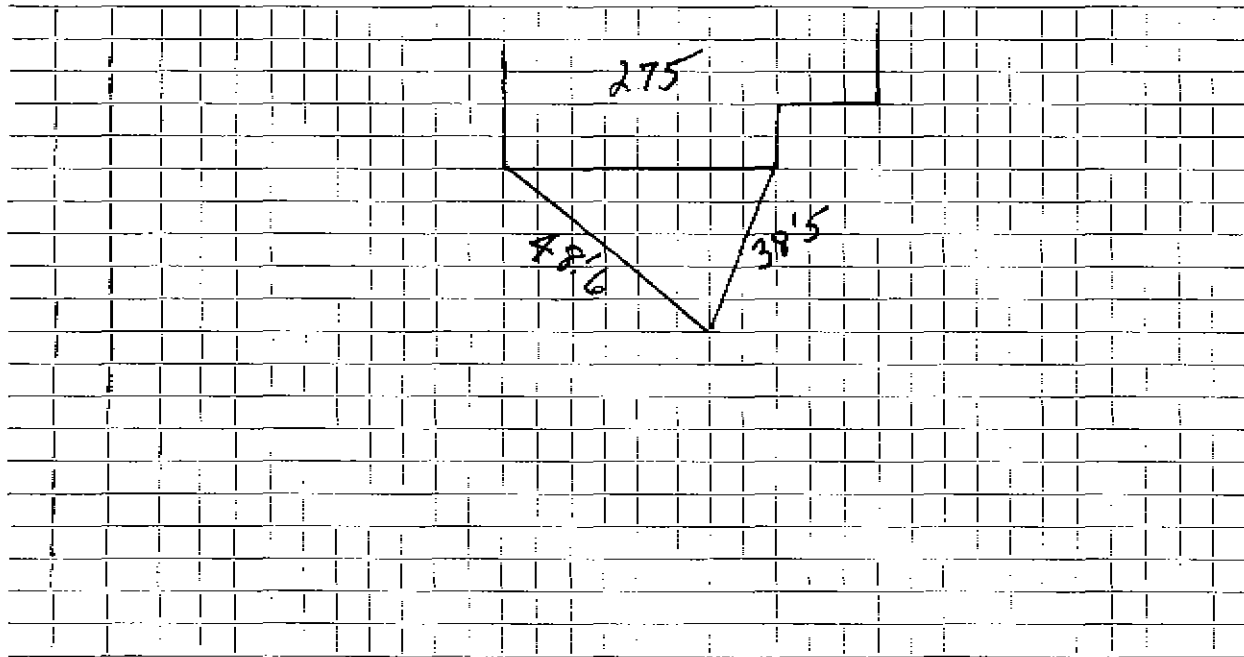

Connection made in Street. Work completed

Remarks:
.....
.....