

WATER SERVICE RECORD

Name

Service No.

Address 279 Concord Ave.

Location

~~Renewal~~ ~~Renewal~~ ~~New Service~~ WO #4362

change to 12" main


Date	Material	Amount	Total	Date	Amount
5/20/76	labor 4 hr. 4 men				
20'	3/4" Copper			4/20/50	
1	3/4" Corp.			54' 3/4 COPPER	
1	3/4 Style 88			1 3/4 x 1/2 S & W	
2	tons cold patch				
2	hrs. trucking				
3	hrs. shovel				
4/20/50	10' 3/4 COPPER				
1	3/4 CURB STEP Box & Rod				

DATE _____

TOWN OF LEXINGTON — BOARD OF PUBLIC WORKS

WATER DIVISION

Sketch of Service Here

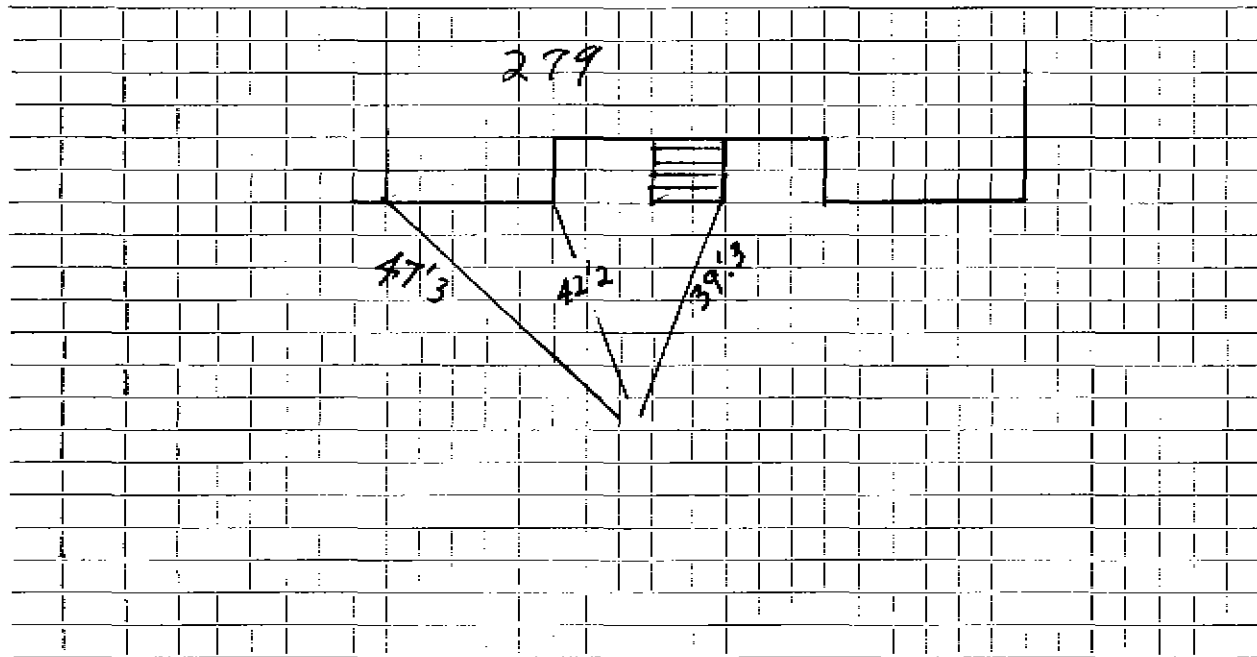

Connection made in Street. Work completed

Remarks:

.....

.....