

## WATER SERVICE RECORD

Name James H. Casella

Service No. 145

Address 291 Concord Avenue

Location Lexington Sewerage Co.-Permit #168

~~Repair of Sewer~~ New Service W.O. #9387 CHANGED TO 12" MAIN

FEB 15 1965


Date	Material	Amount	Total	Date	Amount
				11-30-64	Deposit 75 00
				3-15-65	Paid 28 07
				5/19/76 17'	3/4" COPPER 103 05
					3/4" Corp + 3/4" Union
					CURB TO MAIN
				12-11-64	Labor 39.02
					10% O.H. 3.90
					42 92
				24'	3/4" Copper tubing @.42 10 08
				1	3/4" Corp Cock 7 41
				1	3/4" Curb Cock 8 76
				1	Box & Rod 4 90
					10 x 3 Patch 10 00
				2	Hrs. Town Shovel @6.50 13 00
				2	Hrs. Town Truck @ 3.00 6 00
					103 07
64	134'	3/4" Copper tubing			
					Bill sent 28 07

DATE \_\_\_\_\_

TOWN OF LEXINGTON — BOARD OF PUBLIC WORKS

WATER DIVISION

Sketch of Service Here

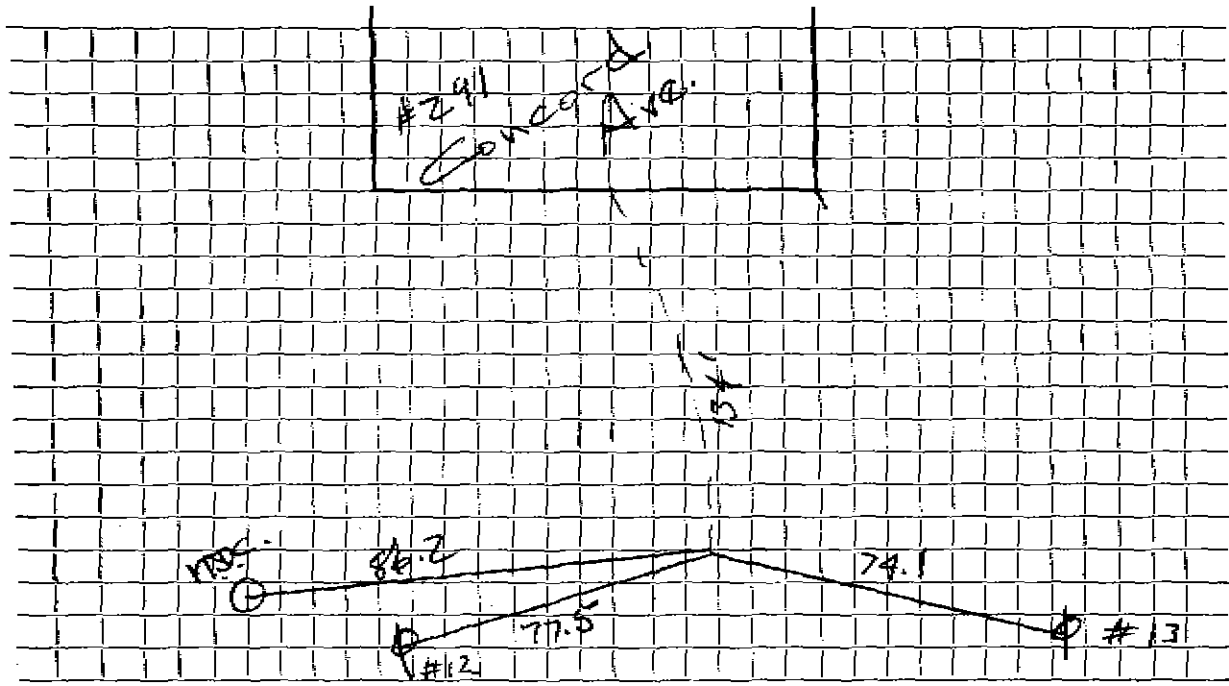

Connection made in ..... Street. Work completed .....

Remarks: .....  
.....  
.....