## WATER SERVICE RECORD

Name

Service No.

Address 294 CONCORD AVE.

Location


Date	Material	Amount	Total	Date		Ameun
<del></del>		<del></del>	<del></del>	#		
				#		
				i l		Ţ
	<del></del>		<del> </del>	<del> </del>	+	<del></del>
			<del></del>	<del>   </del> -	ļ	
		<del>-</del>	<del> </del>	<del> </del>	<del> </del>	
			<u> </u>	<b>   </b>	·	
			ĺ	\\ \ \ \		
		<del></del>	<del> </del>	<del> </del>	<del> </del>	
			<u> </u>	<u> </u>		
ļ ļ						
<del></del>		<del></del>	<del> </del>	<u> </u>	<del> </del>	
\ \						
				<del> </del>		
		<del></del>	<del> </del>	<del> </del>	<del> </del>	
į l				<u> </u>		ì

-	
DATE	•

## TOWN OF LEXINGTON - BOARD OF PUBLIC WORKS

## WATER DIVISION

## Sketch of Service Here

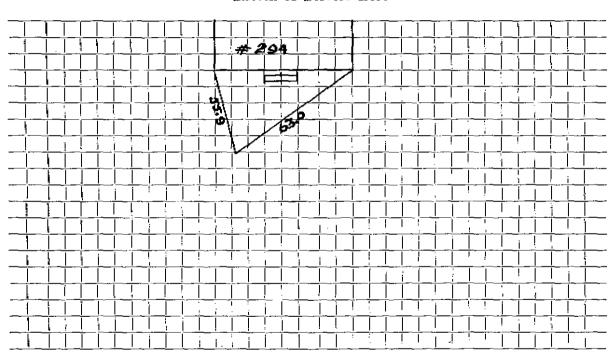

Connection made in	Work completed
Remarks:	***************************************