


DATE _____

TOWN OF LEXINGTON — BOARD OF PUBLIC WORKS

WATER DIVISION

Sketch of Service Here

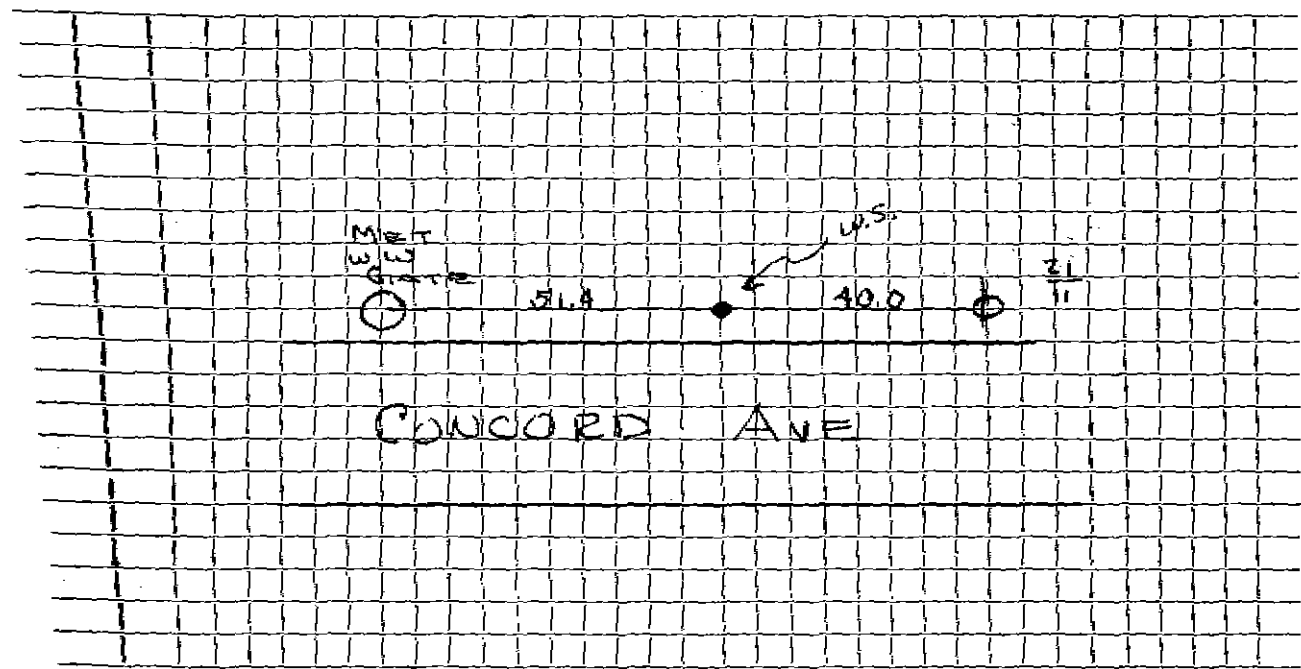

33

MPC
DATE 1/21/10
10511
10511

Connection made in Street. Work completed

Remarks:
.....
.....