

WATER SERVICE RECORD

Name

Service No.

Address


303 Concord Ave

Location

Repair—Renewal—New Service

Date	Material	Amount	Total	Date	Amount
1226.03	133' - 1" Copper 2 - 1" 3pt unions 1 - 1" x 3/4" 3pt union 1 - Buffalo Box			4.14.59	12' 3/4 copper 3/4" curb 3/4" corp
				5.17.76	16' 3/4 Copper 1 - 3 pt union 1 - 3/4 corp Change over to 12" main

TOWN OF LEXINGTON — BOARD OF PUBLIC WORKS
WATER DIVISION

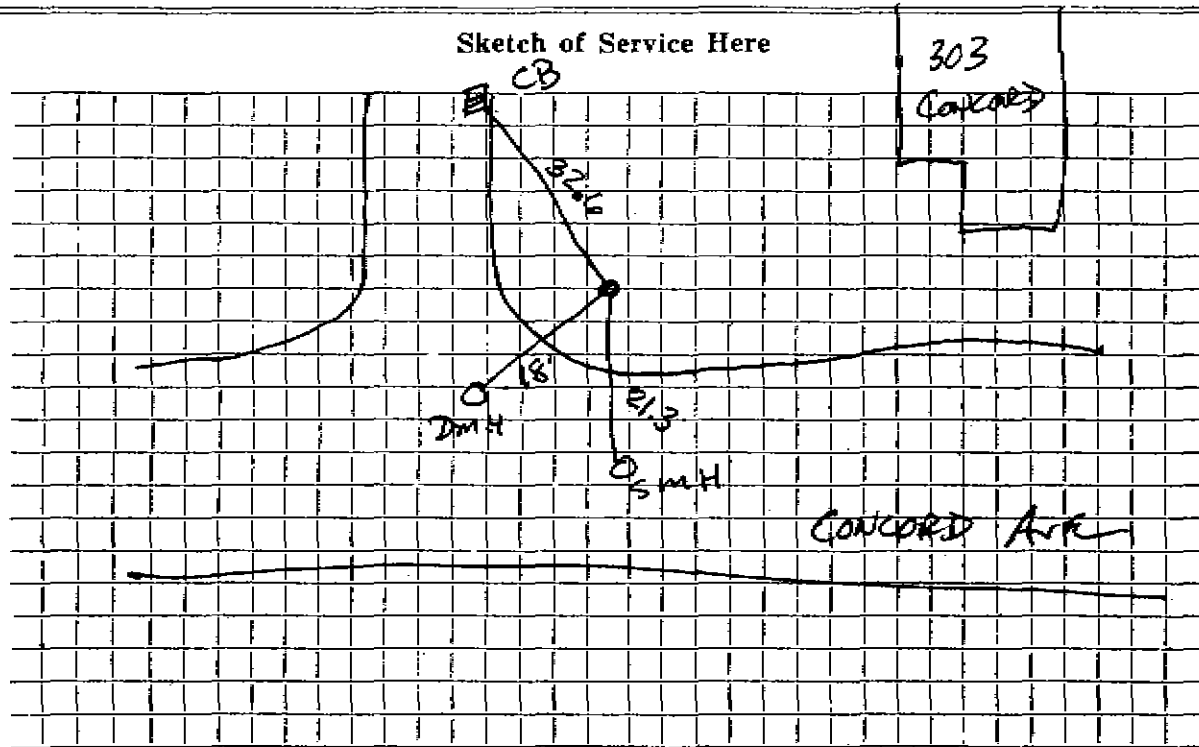

Connection made in Street. Work completed

Remarks: Old 3/4" Copper left in trench beside
..... NEW 1" SERVICE