

WATER SERVICE RECORD

Name

Service No.

Address 310 Concord Ave.

Location

~~Repair~~ ~~Renewal~~ ~~New Service~~
change to 12" water main


Date	Material	Amount	Total	Date	Amount
4/13/76	labor 4 men 4 hrs.			1/27/50	INSIDE
5/13/76	labor 4 men 1 hr.			55'	3/4 COPPER
	9' 3/4" Copper			1	3/4-x 1/2-S&W
	1 3/4" Corp.				
	1 3/4" 3 part union				
	2 tons cold patch				
	4 hrs. trucking				
	2 hrs. shovel				
	1/2 hr. compressor				
1/27/50	21' 3/4 COPPER				
	1 3/4 Curb STOP				
	1 Box + Rod				

DATE _____

TOWN OF LEXINGTON — BOARD OF PUBLIC WORKS

WATER DIVISION

Sketch of Service Here

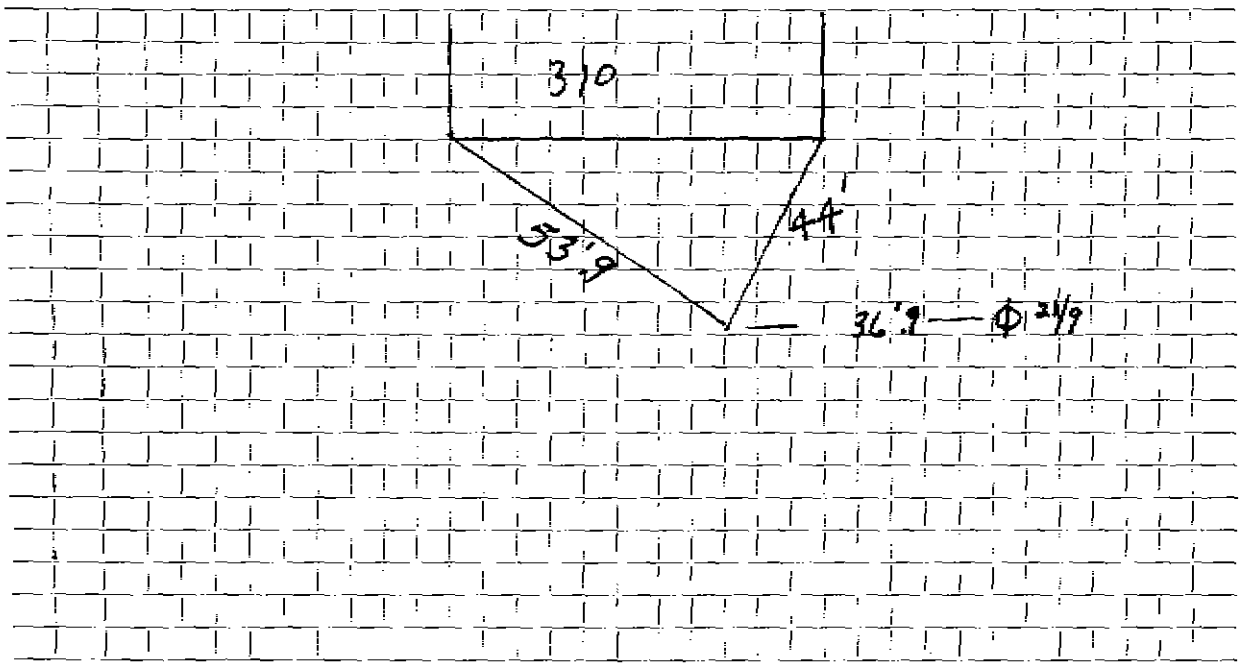

Connection made in Street. Work completed

Remarks:
.....
.....