

Name

Service No.

Address 311 CONCORD AVE

Location

Kind of Pipe

Size

Size of Main

Repair—Renewal—New Service

Location

Date

Material

Amount

Total

Date

Amount

1" TYPE K COPPER


1" CURED STOP
CAMB. PRISM OPEN(R)

DATE _____

TOWN OF LEXINGTON — BOARD OF PUBLIC WORKS

SEWER DIVISION
Water

Sketch of Service Here

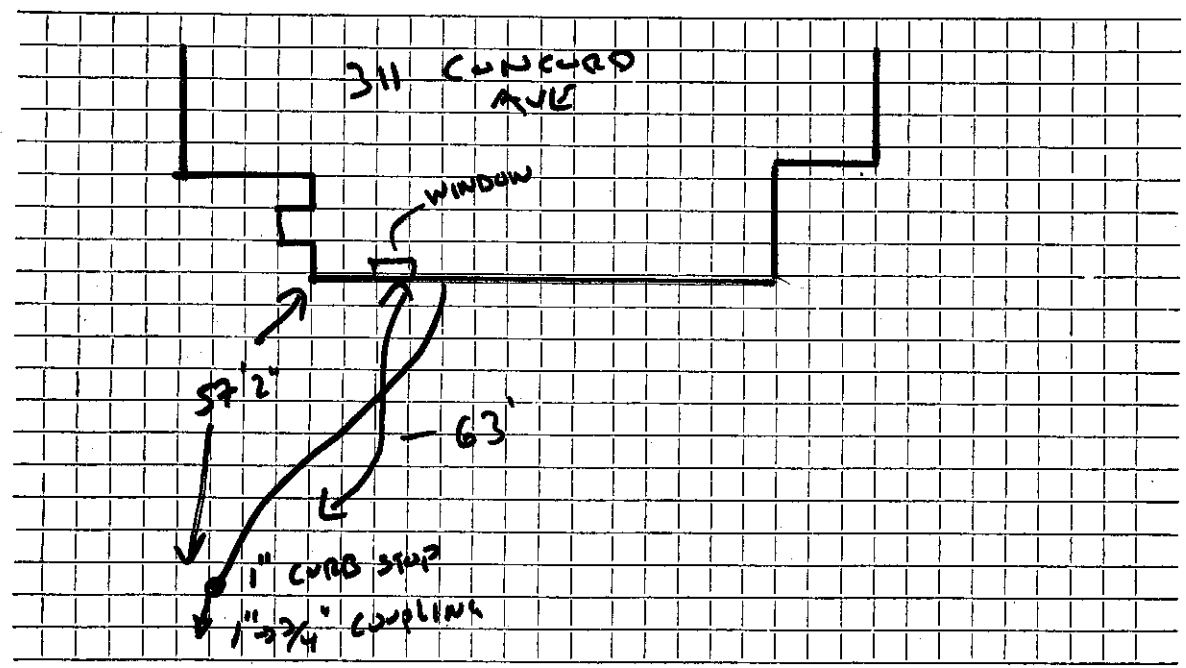

Connection made in CONCURED Street. Work completed FRITTON

Remarks:

.....

.....