

WATER SERVICE RECORD

Name

Service No.

Address 314 Concord Ave.

Location

~~Repair~~—Renewal—~~New Service~~ WO #4233

change to 12" main

| Date    |     | Material           | Amount | Total | Date | Amount |
|---------|-----|--------------------|--------|-------|------|--------|
| 4/13/76 |     | labor 4hrs. 4 men  |        |       |      |        |
| 5/13/76 |     | labor 1hr. 4 men   |        |       |      |        |
|         |     | labor 3 hrs. 5 men |        |       |      |        |
|         | 5'  | 3/4" Copper        |        |       |      |        |
|         | 1   | 3/4" 3 part union  |        |       |      |        |
|         | 1   | 3/4" Corp.         |        |       |      |        |
|         | 2   | tons cold patch    |        |       |      |        |
|         | 7   | hrs. trucking      |        |       |      |        |
|         | 2   | hr. roller         |        |       |      |        |
|         | 1/2 | hr. comp.          |        |       |      |        |
|         | 2   | hr. shovel         |        |       |      |        |
| 5/31/49 | 21' | 3/4 COPPER         |        |       |      |        |
|         | 1   | 3/4 CURB COCK      |        |       |      |        |
|         |     | Box + Rod          |        |       |      |        |

INSIDE

5/31/49

216 3/4 COPPER


1 3/4 x 1/2 S + W

1 3/4 UNION 3 PART

DATE \_\_\_\_\_

**TOWN OF LEXINGTON — BOARD OF PUBLIC WORKS**  
**WATER DIVISION**

Sketch of Service Here

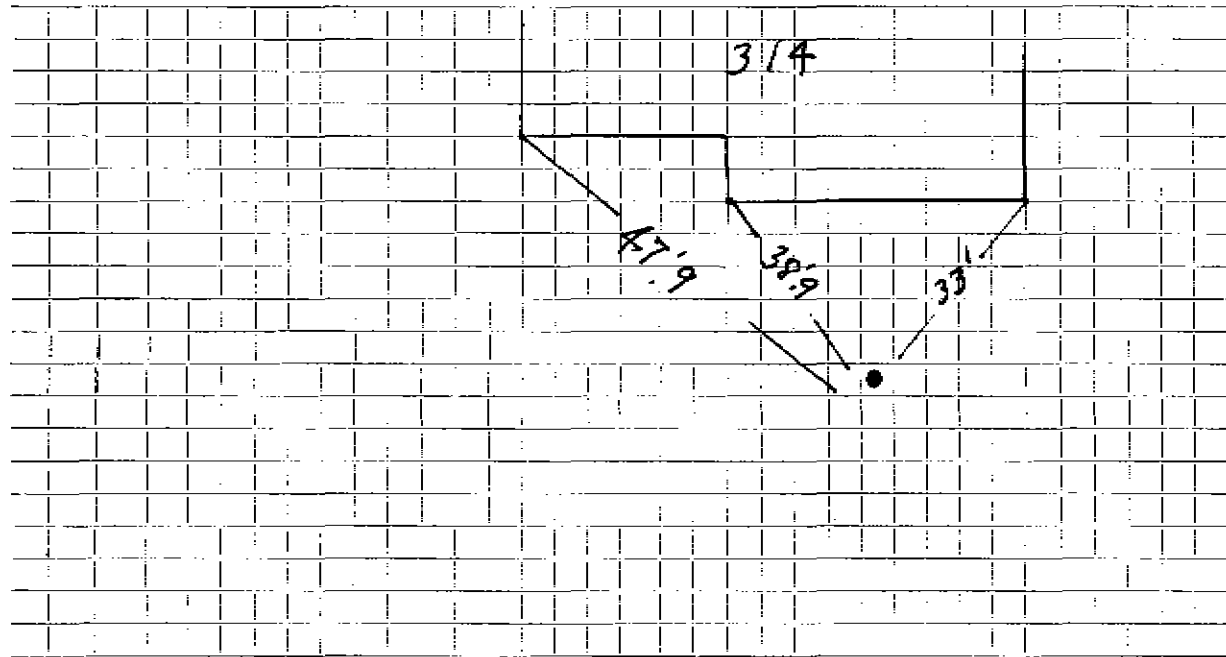

Connection made in ..... Street. Work completed .....

Remarks: .....  
.....  
.....