

## WATER SERVICE RECORD

Name

Service No.

Address


Location 320 CONCORD AVENUE

Repair—Renewal—New Service CHANGED TO 12" 1976

Date	Material	Amount	Total	Date	Material	Amount	Total
10/19/49	43' 3/4 COPPER 1 3/4 x 1/2 S+W			10/19/49	21' 3/4 COPPER 1 3/4 CURB COCK BOX + ROD		
				5/17/76	1 3/4 CORP		

WATER DIVISION

Sketch of Service Here

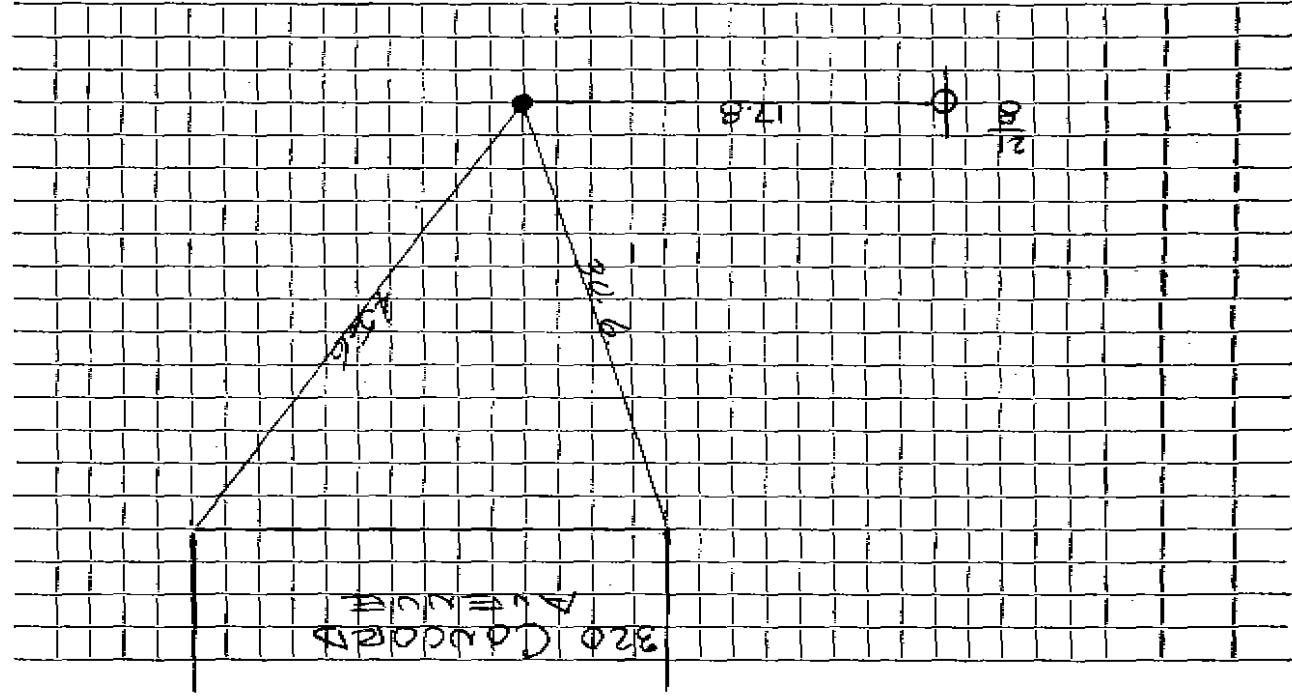

Connection made in \_\_\_\_\_ Street. \_\_\_\_\_ Work completed \_\_\_\_\_  
Remarks: \_\_\_\_\_