

WATER SERVICE RECORD

Name

Service No.

Address

Location 324 Concord Avenue

Repair—Renewal—New Service


CHANGED TO 12" 1976

Date	Material	Amount	Total	Date	Material	Amount
1/28/50	53' 3/4 COPPER			1/28/50	21' 3/4 COPPER	
	1 3/4 x 1/2 S + W				1 CURB COCK	
	1 3/4 UNION (3 PTS)				BOX + ROD	
				5/13/76	3' 3/4 COPPER	
					1 3/4 CORP	
					1 (3 PTS) UNION	

TOWN OF LEXINGTON — BOARD OF PUBLIC WORKS

WATER DIVISION

DATE _____

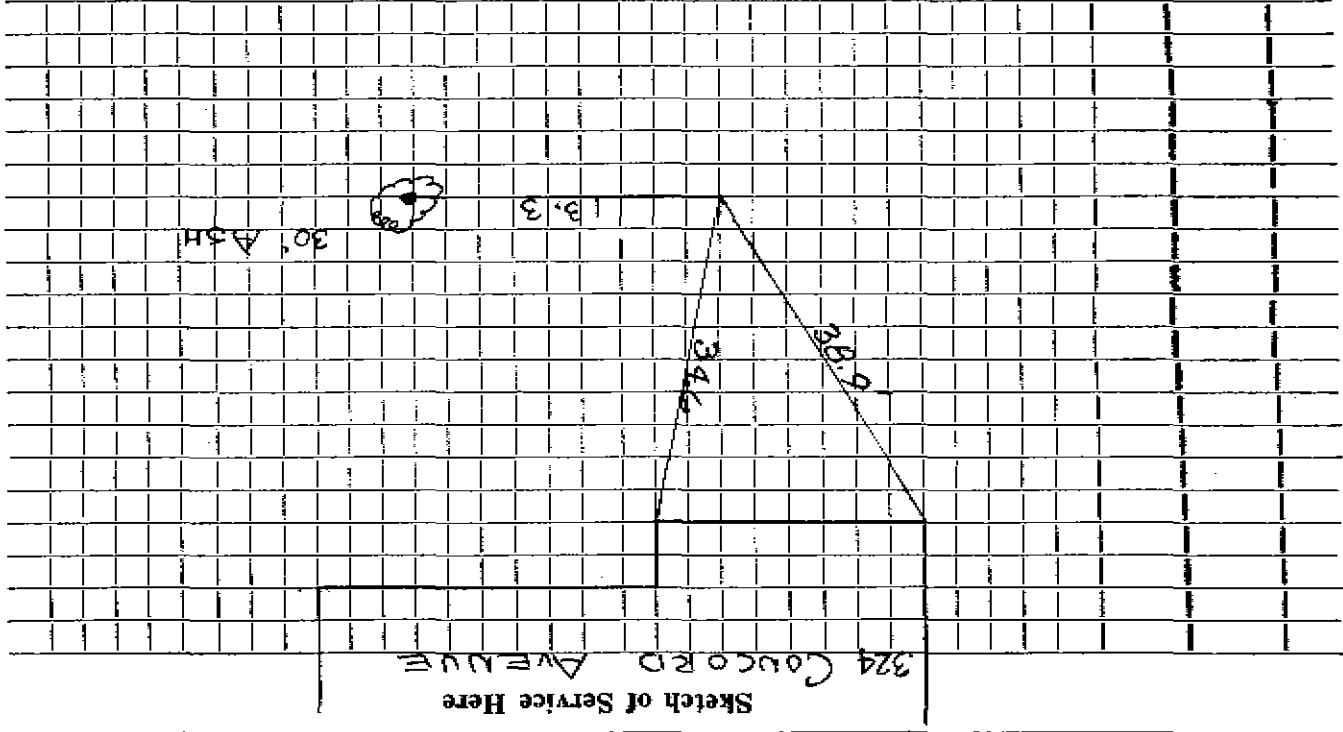

Connection made in _____

Street _____

Work completed _____

Remarks: _____

