

WATER SERVICE RECORD

Name

Service No. 2057

Address 334 CONCORD AVE

Location


Repair—Renewal—New Service T.D. John L. Telfield 18.

Date	Material	Amount	Total	Date	Excess	Amount
3/29/06	1" Copper			6/3/52	3/4 Copper	
	1' 3/4 C.				3/4 Corp	
	1 3/4 X 1" UNION				3/4 Coupl	
	bufflo box					
				4/12/76	Changed To 12" WATER	
					3' 3/4 copper	
					1 3/4 Corp	
					1 3/4 UNION	

DATE \_\_\_\_\_

TOWN OF LEXINGTON — BOARD OF PUBLIC WORKS  
WATER DIVISION

Sketch of Service Here

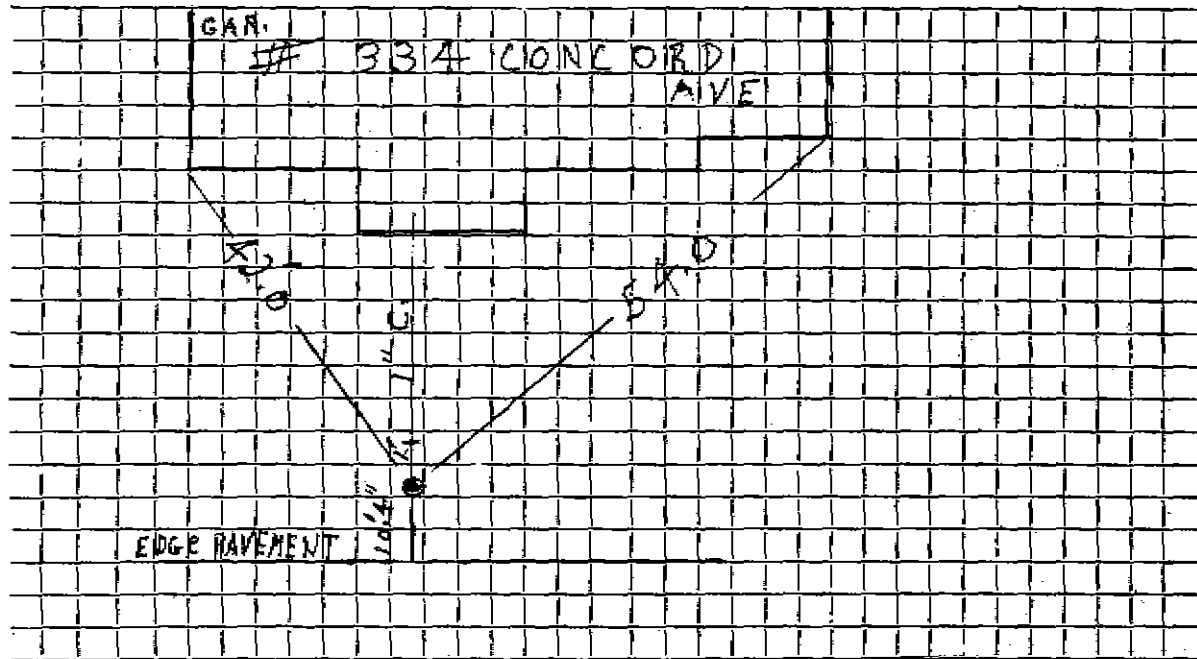

Connection made in \_\_\_\_\_ Street.

Work completed 3/29/06 John L. Tebfield JR.

Remarks: 1\" 3/4\" curb To 3/4\" UNION