

Name

Service No. 629

Address 342 Concord Ave.

Location 342 Concord Ave.

Kind of Pipe

Size

Size of Main

Repair—Renewal—New Service

Location

Date

Material

Amount

Total

Date

Amount

Labor

TOWN OF LEXINGTON—BOARD OF PUBLIC WORKS

WATER DIVISION

The undersigned applies for a supply of water at No. _____ St. and hereby agrees to comply with the rules and regulations as now, or at any future time, established by the Board of Selectmen.

Am't. of Estimate \$ _____

Owner


Am't. Paid \$ _____

Address

J. Ballou
342 Concord Ave.

Builder _____

Sketch of Service Here

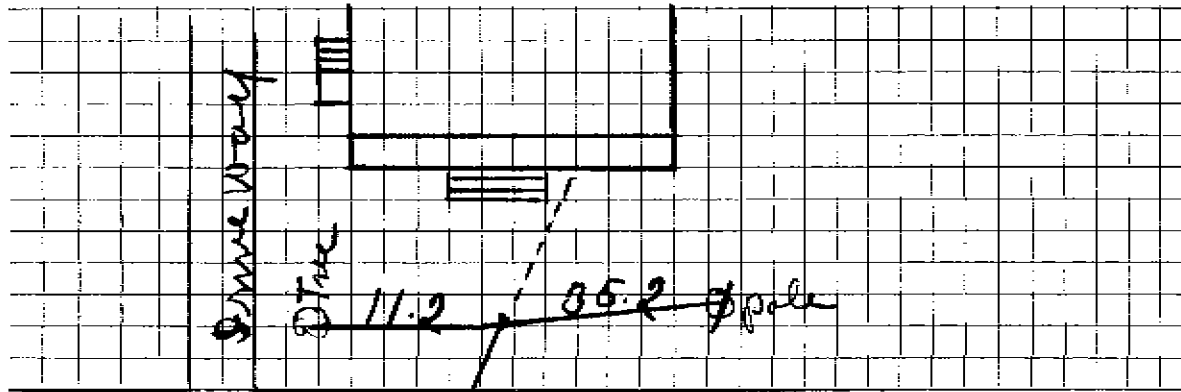

Connection made in Concord Ave Street.

Work completed _____ 19

Remarks:

11.5
Dime