




DATE \_\_\_\_\_

**TOWN OF LEXINGTON — BOARD OF PUBLIC WORKS**

**WATER DIVISION**

Sketch of Service Here

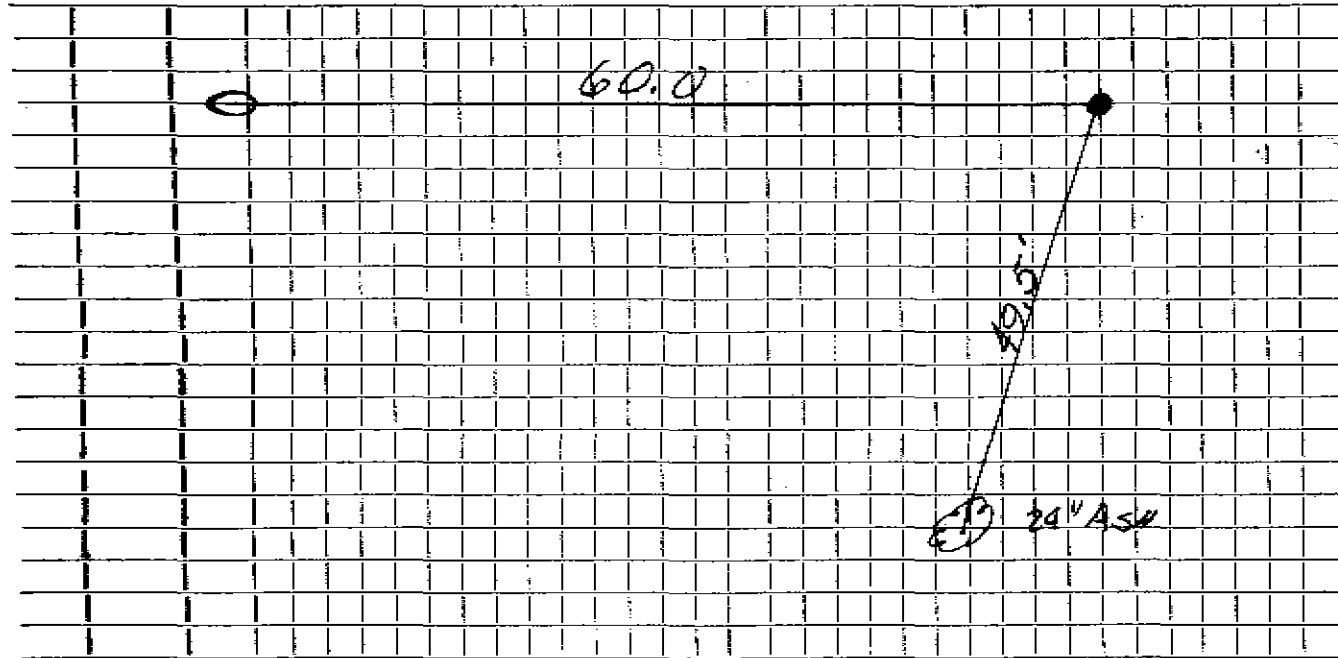

Connection made in . . . . . Street. Work completed . . . . .

Remarks: . . . . .  
. . . . .  
. . . . .