

## WATER SERVICE RECORD

Name

Service No.

Address 353 Concord Ave.

Location

~~Repair—Renewal—New Service~~ WO #4222

Change to 12" water main

Date	Material	Amount	Total	Date	Amount
4/12/76	labor 5 hr. 5 men			7/18/49	INSIDE
5/14/76	labor 1 hr. 4 men			44'	1" COPPER
	20' 1" Copper			1	1" x 1" S+W
	1 1" Corp.			2	3/4" tail piece
	1 1" 3 part union				
	3 tons cold patch				
	2 1/2 hr. trucking				
	1/2 hr. comp.				
	3 hr. shovel				
7/18/49	1 1" Curb STOP				
	BOX & Rod				
	10' 1" COPPER				

DATE \_\_\_\_\_

TOWN OF LEXINGTON — BOARD OF PUBLIC WORKS

**WATER DIVISION**

Sketch of Service Here

A large grid of graph paper, approximately 20 columns wide and 20 rows high, intended for sketching service lines. The grid is empty.

Connection made in ..... Street. Work completed .....

Remarks: .....  
.....  
.....




DATE \_\_\_\_\_

TOWN OF LEXINGTON — BOARD OF PUBLIC WORKS

WATER DIVISION

Sketch of Service Here

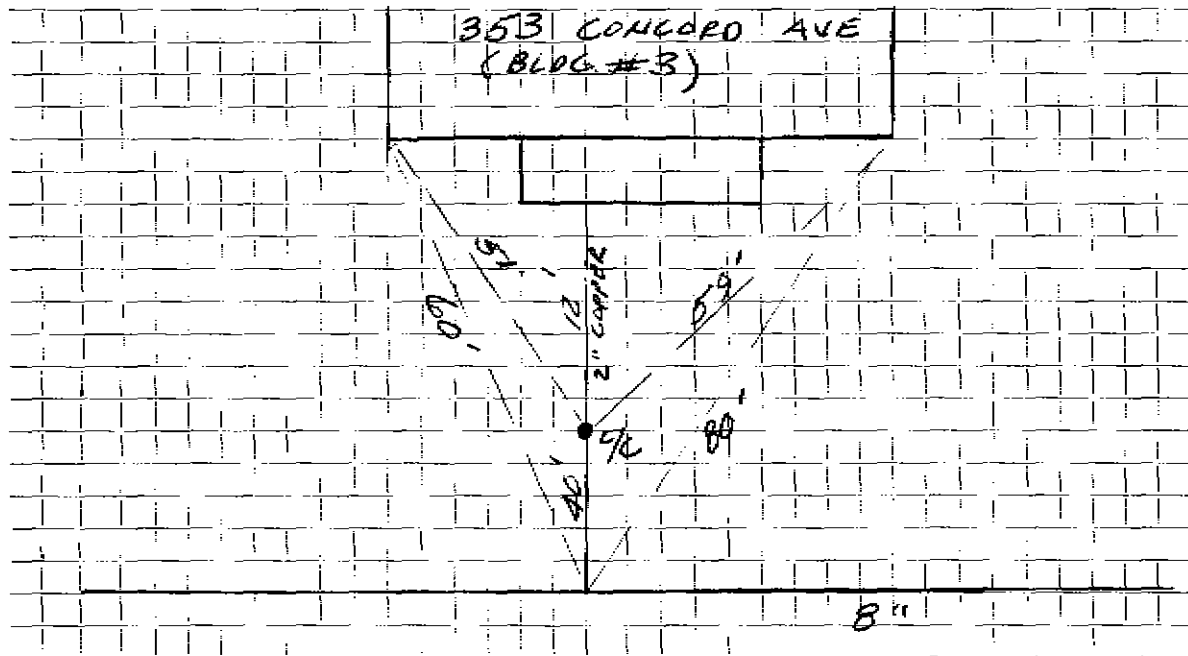

Connection made in ..... Street. Work completed .....

Remarks: .....

.....

.....