


EXHIBIT
1" WATER
SERVICE

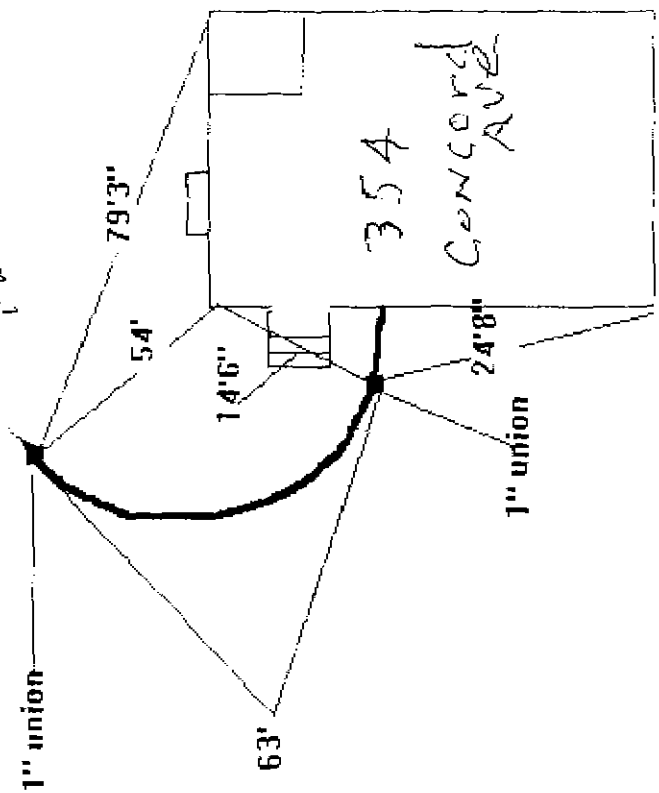


ES
ORD AVE

DATE _____

TOWN OF LEXINGTON — BOARD OF PUBLIC WORKS

WATER DIVISION

Sketch of Service Here

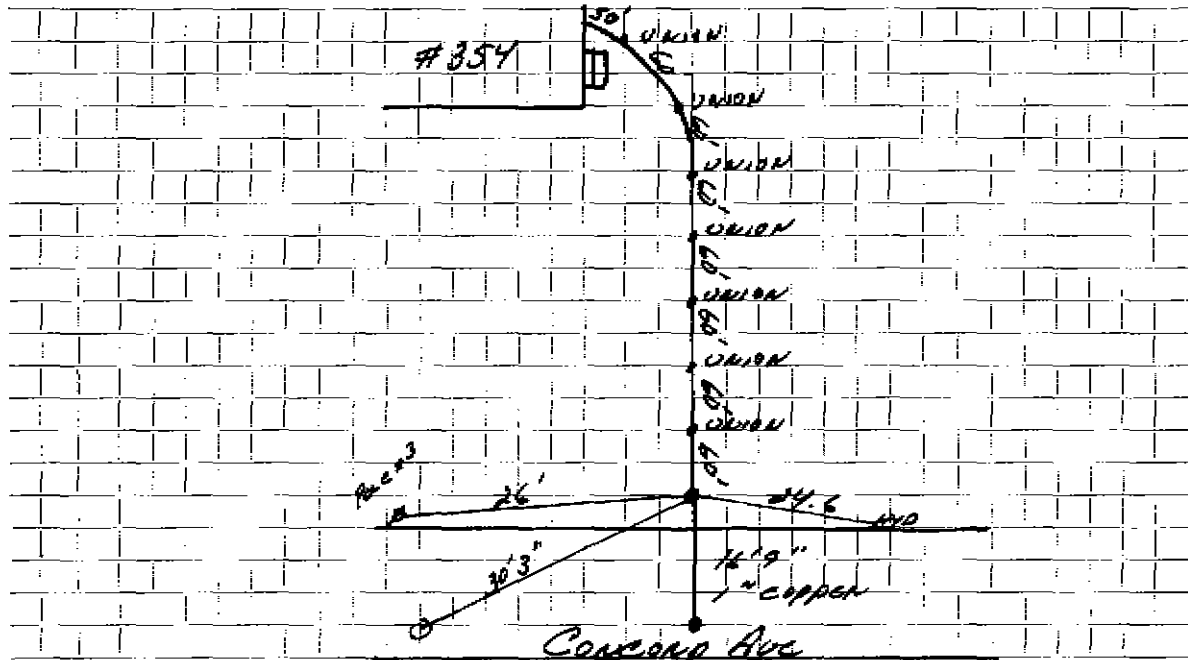

Connection made in Concord Ave 1" Street. Work completed

Remarks: was 950 Waltham St,