

WATER SERVICE RECORD

Name

Service No.

Address 365 Concord Ave.

Location

~~Repair~~—~~Renewal~~—~~New Service~~ WO #4219
change water service to 12"


Date	Material	Amount	Total	Date	Amount
	<i>TICITL</i>				
4/8/76	labor-4 men				
5/14/76	labor-4 men, 1½ hrs.			39'	3/4" Copper
	20' 3/4" Copper			1	3/4" Curb
	1 Style 88 3/4"			1	3/4" Corp.
	2½ hr. trucking			1	box and rod
	4 hr Town Shovel			3	tons cold patch
	½ hr. comp.				<i>Changed to 12"</i>
7/22/60	114' 3/4 COPPER				
	1 3/4 SAW				

DATE _____

TOWN OF LEXINGTON — BOARD OF PUBLIC WORKS

WATER DIVISION

Sketch of Service Here

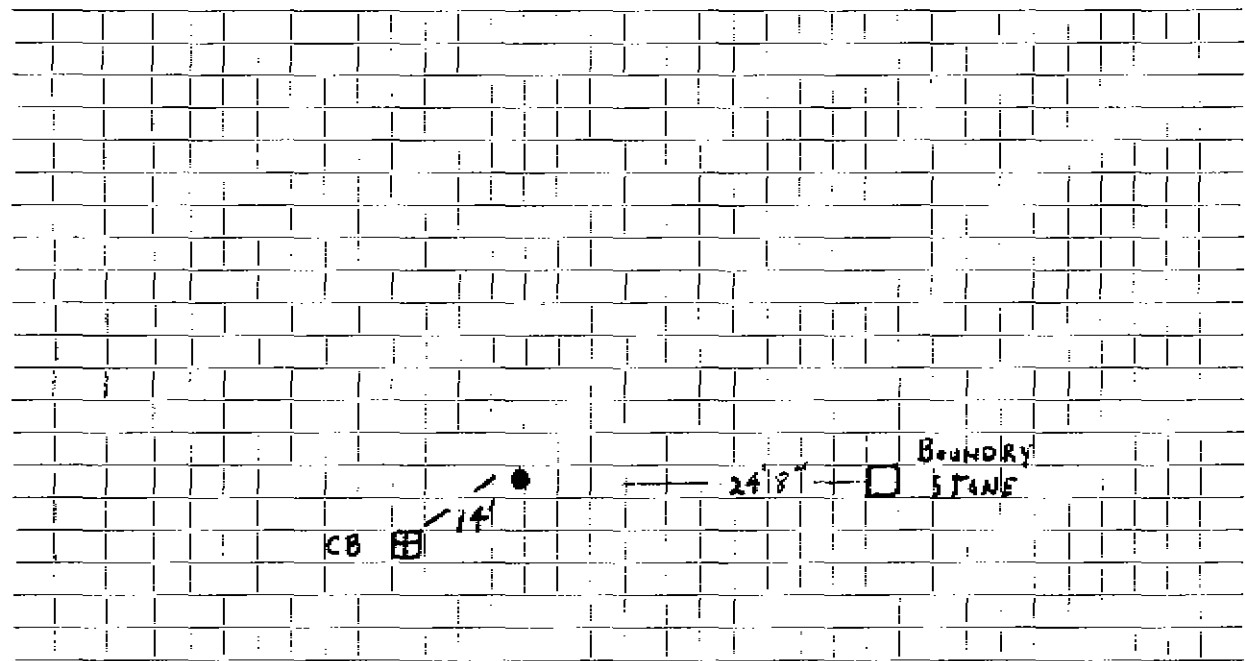

Connection made in Street. Work completed

Remarks: CHANGED TO 12"
.....
.....