

Name G. W. ~~Easton~~  
 Address 382 Concord Avenue

Service No. 116

Location 382 Concord Avenue

Kind of Pipe Size Size of Main

~~Repair-Replace~~ New Service Com. 8-15-49 Location

Date	Material	Amount	Total	Date	Amount
July 7, '49	Labor	2 35	2 35	<del>July 20, '49 Deposited</del>	55 00
	10% Overhead		24	<del>July 25, '49 Payment</del>	
	72' - 3/4" Copper Tubing @.24		17 28	<del>Non-Charge</del>	45 30
	1 - 3/4" C x 1/2" I.W.H. S&W		3 29	July 7, '49 Labor	6 75
	1 - 3/4" C x 3/4" C Union		1 39	32' - 3/4" Copper Tubing @.24	7 68
	Trucking 1 hr.		75	1 - 3/4" C Corp-cock	3 15
	Patching 20 x 3		20 00	1 - 3/4" C x 3/4" C Curb-cock	3 85
			45 30	1 - Box & Rod	3 95
				2 - 3/4" Straight Tail Piece	74
				3 1/2 hrs. Littlefield Shovel @7.00	24 50
				Trucking 1 hr.	75
	Labor			Aug 02 9' 1" Copper	51 37
				1" Corp	
				1" Curb	
				1x 3/4 Red	
				bufflo box	

DATE \_\_\_\_\_

TOWN OF LEXINGTON - BOARD OF PUBLIC WORKS

**WATER DIVISION**

The undersigned applies for a supply of water at No..... St. and hereby agrees to comply with the rules and regulations as now, or at any future time, established by the Board of Selectmen.

Am't of Estimate \$.....


Owner .....

Am't Paid \$.....

Address .....

Builder .....

Sketch of Service Here

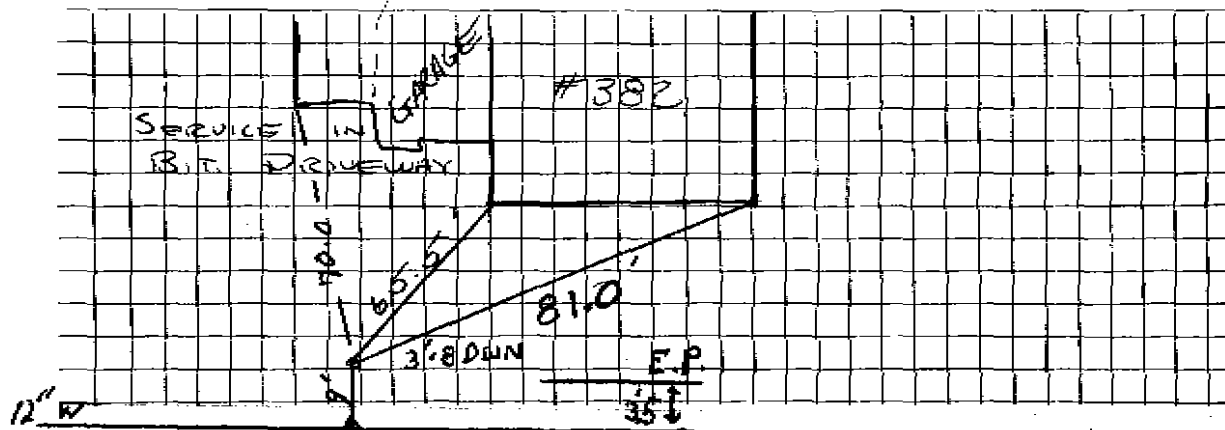

Connection made in ..... D.W.P.N. 1.5' ..... Street.

Remarks:

Work completed Aug. 2002 ..... 19

DMH