

## WATER SERVICE RECORD

Name Mrs. John Dias

Service No. 219

Address 389 Concord Ave.

Location

~~Repair~~ Renewal ~~New Service~~


Comm. 12-9-57

Date	Material	Amount	Total	Date	Amount
10/3/57	labor	35 91		9-30-57	Deposit 100 00
	10% overhead	3 59		12-2-57	Refund 28 16
			39 50		NON CHARGE 71 84
	45' 3/4" copper tubing @ .375		16 88		labor 8 01
	1 3/4" C x 1/2" IWH stop & waste		4 96		10' 3/4" copper tubing .375 3 75
	1 hr trucking		75		1 3/4" C corp cock 4 64
	1 1/2 hr. town shovel @ 6.50		9 75		1 3/4" curb cock 5 94
			71 84		1 box & rod 4 62
					1 1/2 offset tail piece 50
					1 1/2 straight tail pc. 50
					3x3 patch 3 00
					30 96

TOWN OF LEXINGTON — BOARD OF PUBLIC WORKS

WATER DIVISION

Sketch of Service Here

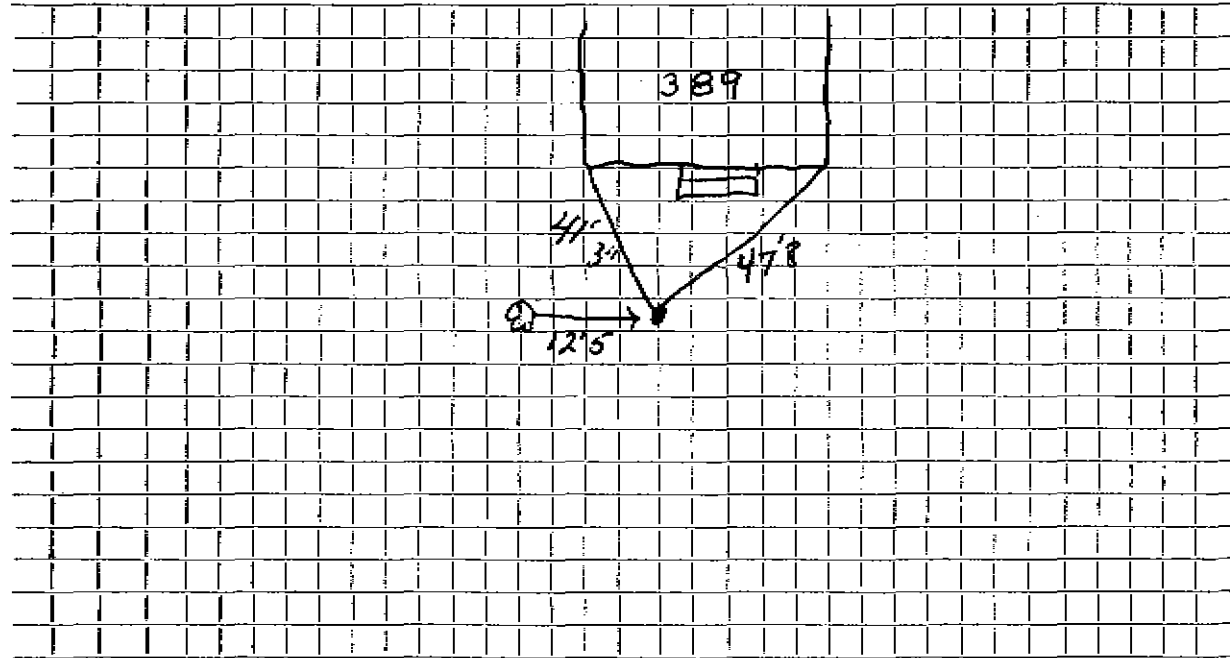

Connection made in ..... Street. Work completed .....

Remarks: .....

.....

.....