

WATER SERVICE RECORD

Name Service No.

Address ³⁹⁷ Concord Avenue

Location Sta. 78 / 70 (Right Side)

~~Repair/ Renewal~~ — New Service


Date	Material	Amount	Total	Date	Amount
					NON-CHARGE
				9/23/61	Labor 11 04
					6'3/4" Copper Tubing @ .42 2 52
					1 3/4" C Corp Cock 4 91
					1 3/4" C Curb Cock 6 28
					1 Bow & Rod 4 90
					1 Hr. Trucking @ 3.00 3 00
					1 Hr. Town Shovel @ 6.50 6 50
					39 15

DATE _____

TOWN OF LEXINGTON — BOARD OF PUBLIC WORKS

WATER DIVISION

Sketch of Service Here
397

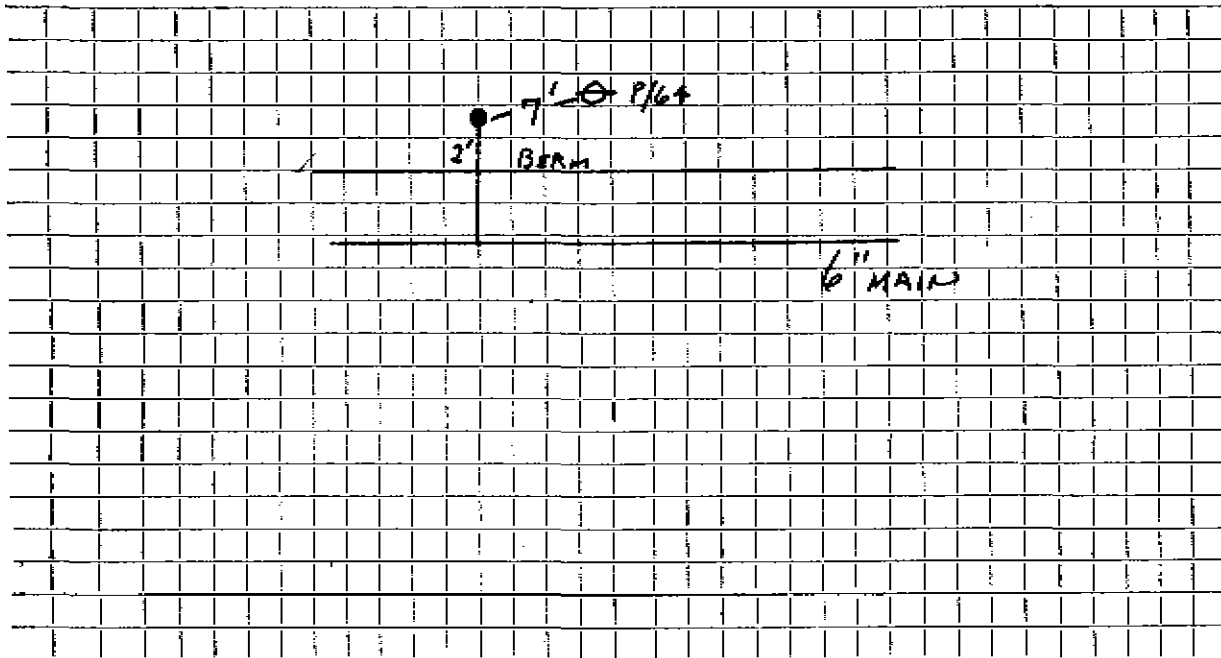

Connection made in Street. Work completed

Remarks:
.....
.....