

WATER SERVICE RECORD

Name

Service No.

Address 404 CONCORD AVE

Location


Repair—Renewal—New Service TEARDOWN McLAUGHLIN

Date		Material	Amount	Total	Date		Material	Amount
DEC 99	75'	1" COPPER 2/4 X 1" INCREASER			8/10/51	22'	3/4 COPPER 3/4 COP 3/4 CURB BOX	
					7/1/56	6'	5/4 C	
						2	3/4 PART UNIONS	
							Dem 2002	
					Aug 02	8.5'	1" Copper 1" COP 1" CURB STOP baffle box	

DATE _____

TOWN OF LEXINGTON — BOARD OF PUBLIC WORKS
WATER DIVISION

Sketch of Service Here

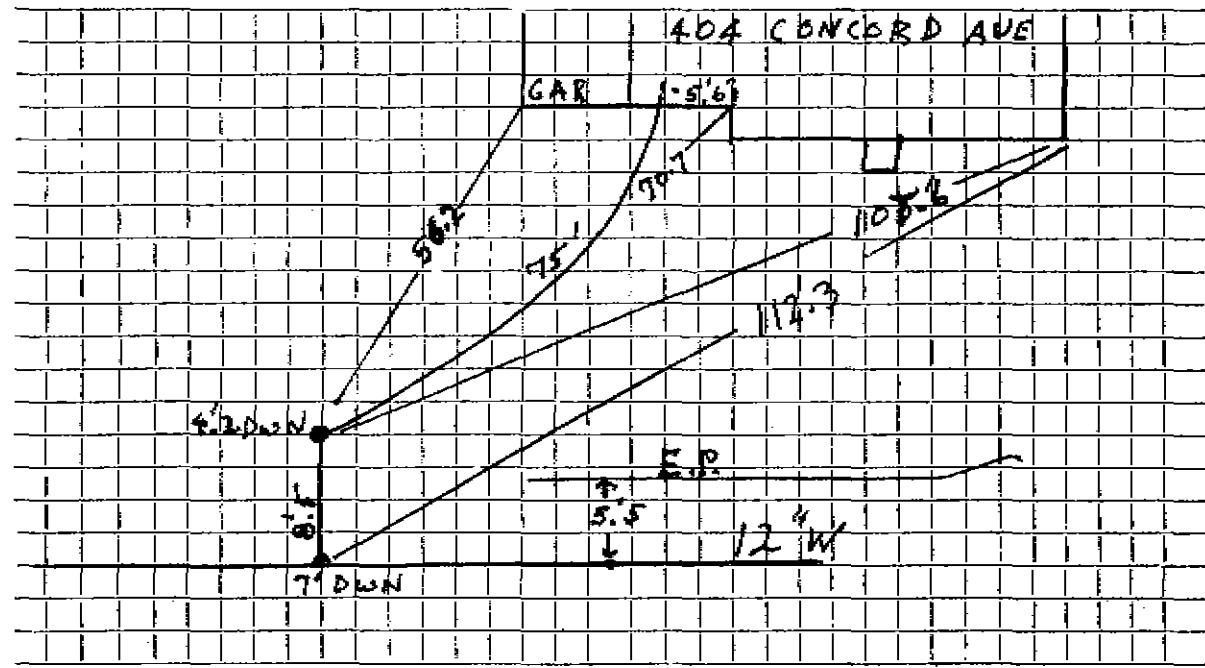

Connection made in Street. Work completed Aug 2007 Demis

Remarks:
.....
.....