

WATER SERVICE RECORD

Name Norman Turnquist

Service No. 80

Address 405 Concord Avenue

Location

Repair—Renewal—New Service *WC# 289*

MAY 29 1973


Date	Material	Amount	Total	Date	Amount
12/15/72	Labor	4 68			
	10% O.H.	47	5 15	<i>11-26-72</i>	<i>Deposit</i>
				<i>5-29-73</i>	<i>Refund</i>
41'	1" Copper pipe .99		40 59		
	1"x1" Stop & Waste		12 53		
1	Hr. Truck		3 00		
			61 27		
					<u>OUTSIDE</u>
					Labor
					137 04
				30'	1" Copper pipe .99
				1	1" Corporation
				1	1" Cure cock
				$\frac{1}{2}$	Ton cold patch 8.00
					Patching 28 x 4'
					12 $\frac{1}{2}$ sq. yds. @ 6.50
					81 25
					275 75

DATE _____

TOWN OF LEXINGTON — BOARD OF PUBLIC WORKS

WATER DIVISION

Sketch of Service Here

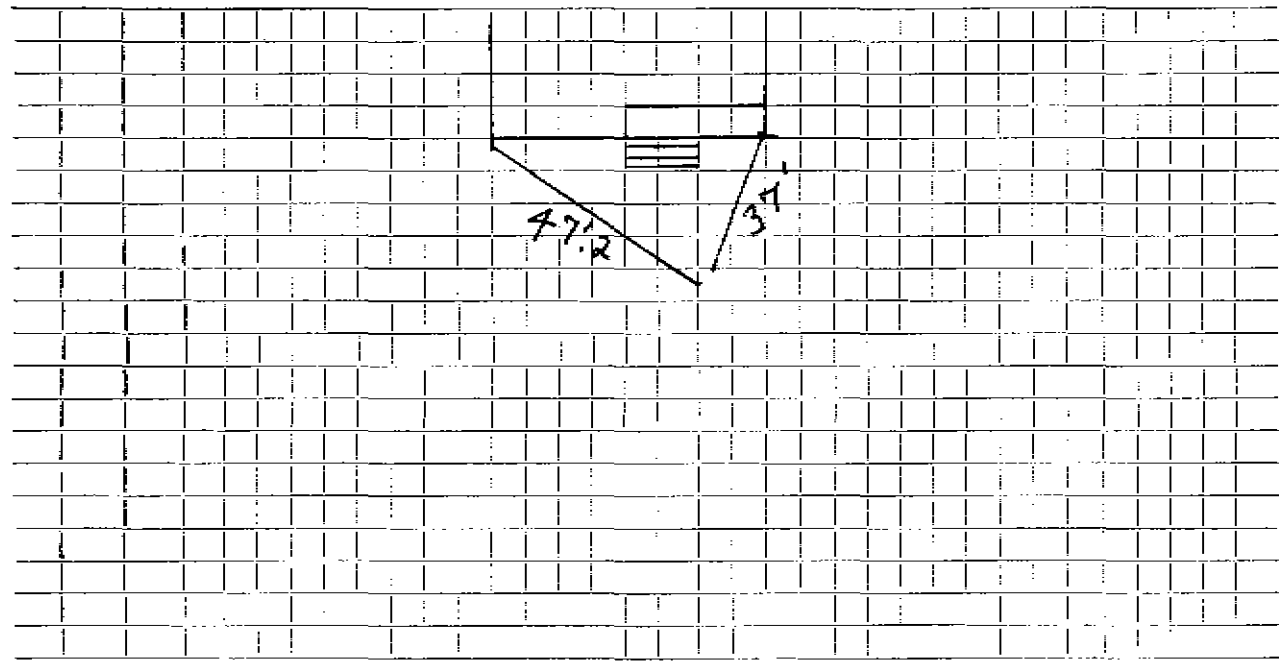

Connection made in Street. Work completed

Remarks:
.....
.....