


DATE _____

TOWN OF LEXINGTON — BOARD OF PUBLIC WORKS

WATER DIVISION

Sketch of Service Here
CONCORD AVE

411

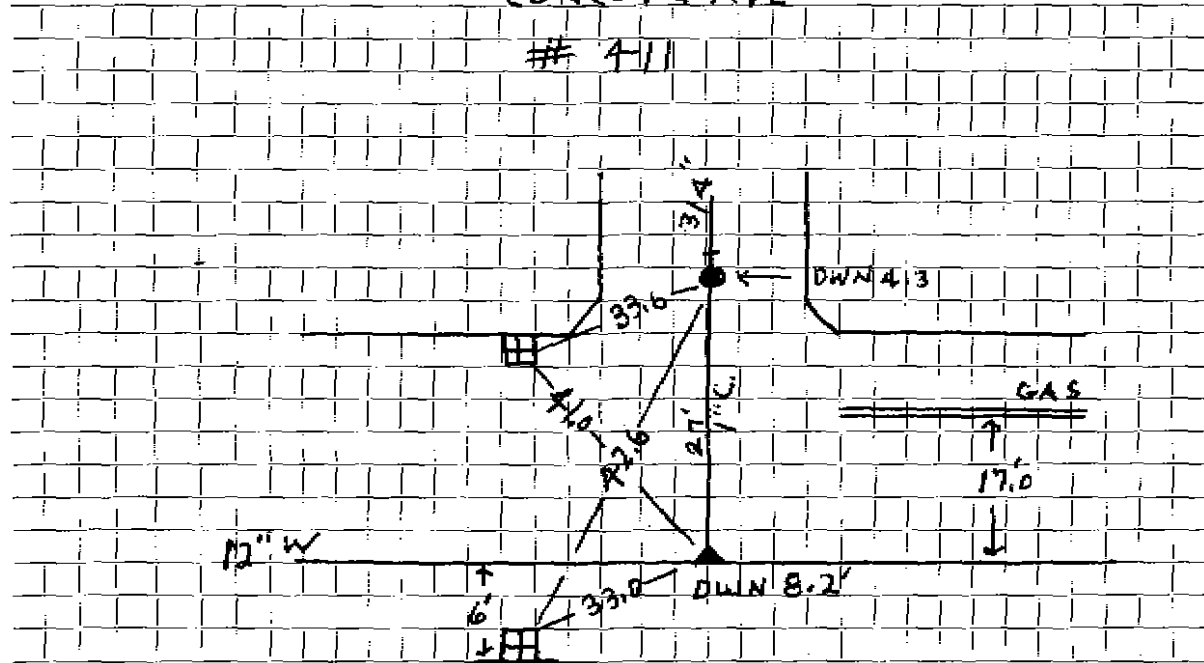

Connection made in _____ Street. Work completed Sept. 2002. Demol. _____

Remarks: OLD CURB DWN 8.3" (OLD RD DWN 3.5") _____