

WATER SERVICE RECORD

Name **Cynthia Nordone**

Service No.

Address **421 Concord Avenue**

Location

~~Repair~~ **New Service Cincotta #3716**


Date	Material	Amount	Total	Date	Amount
7/30/81	82'	1" Copper tubing			
		1" Union - Comp.			
		Stop & Waste Valve			
					OUTSIDE
				7/30/81	32'
					1" Copper tubing
					1" Corporation flare
					1" Curb Stop Comp. fittings
					Box & Rod

DATE _____

TOWN OF LEXINGTON — BOARD OF PUBLIC WORKS

WATER DIVISION

Sketch of Service Here

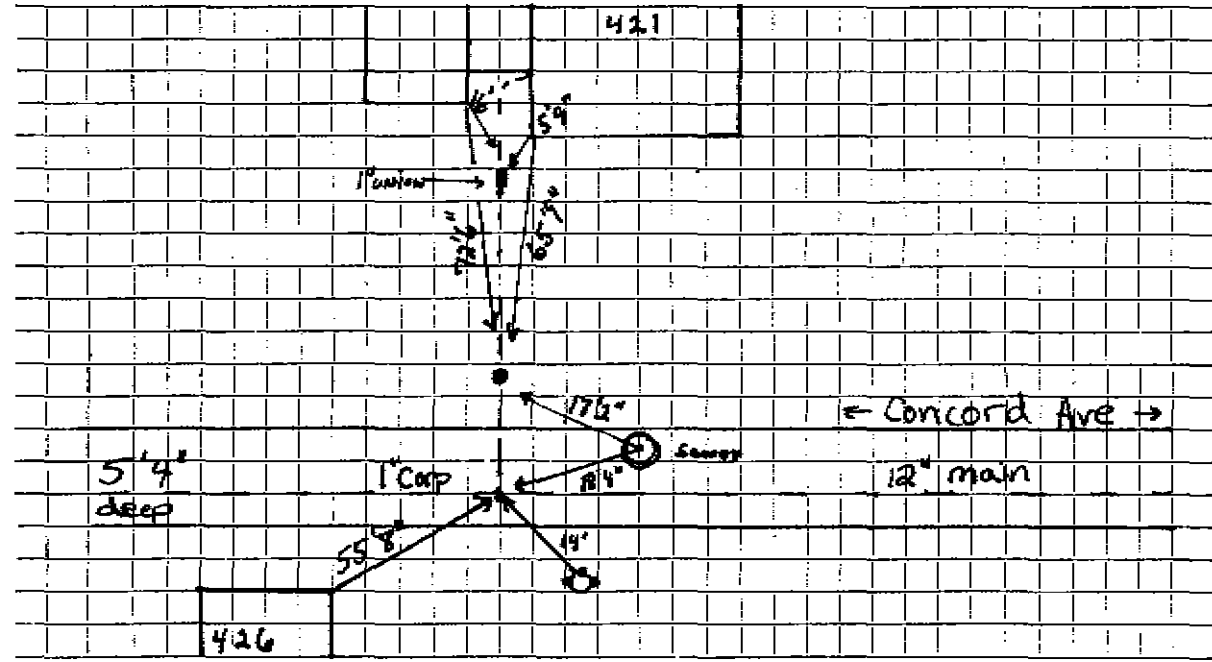

Connection made in Concord Ave. 12" Main Street. Work completed

Remarks:

.....

.....