

WATER SERVICE RECORD

Name

Service No.

Address 426 Concord Avenue

Location

~~Repair~~ ~~Renewal~~ ~~Material~~ ~~Service~~ RENEWAL

Date	Material	Amount	Total	Date	Material	Amount
8/10/49	36' 3/4 COPPER			8/13/49	29' 3/4 COPPER	
	1 3/4 x 1/2 S + W				1 3/4 COPPER	
					NON CHARGE	
				10-17-61	Labor	21.16
					1 hr. Town Shovel @6.50	6.50
					1 hr. Trucking @3.00	3.00
					1 3/4" C. Gurb Cock	4.91
					1 Box & Red	4.90
					(Broken by Cont.)	40.47
				Aug 02	9' 1" Copper	
					1" Corp	
					1" Gurb	
					1 x 3/4 Red	
					bufflo box	


DATE \_\_\_\_\_

# TOWN OF LEXINGTON — BOARD OF PUBLIC WORKS

## WATER DIVISION

Sketch of Service Here

CONCORD AVE

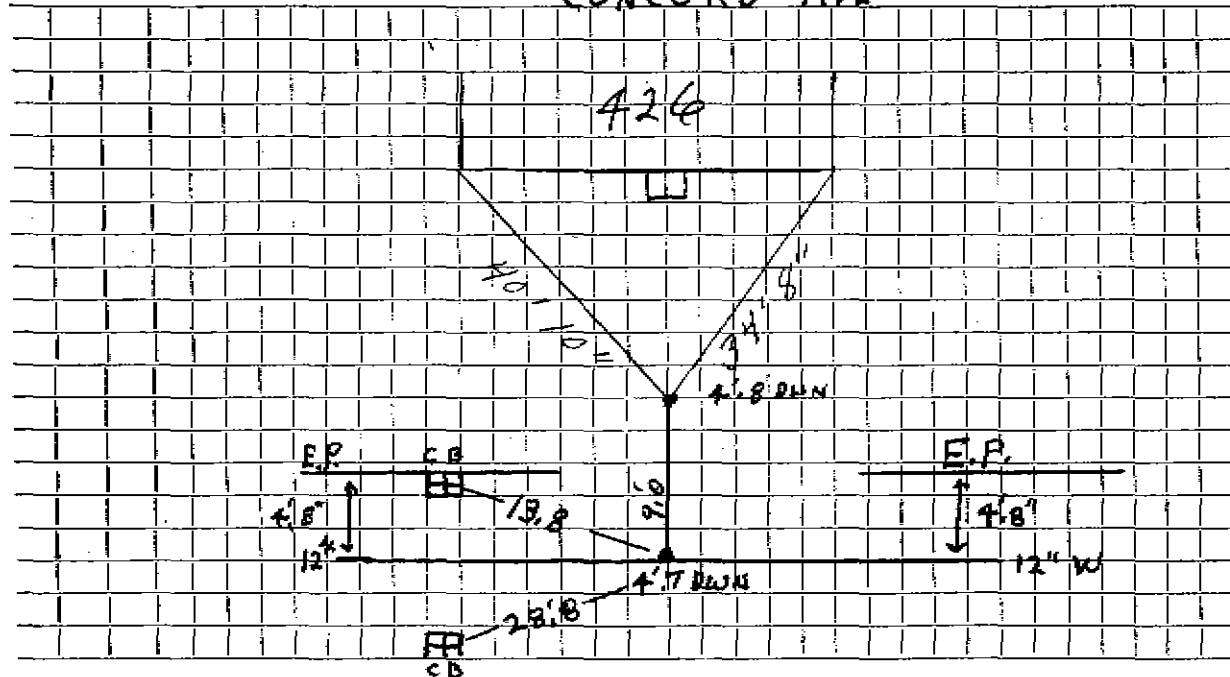

Connection made in \_\_\_\_\_ Street.

Work completed Aug. 2003. DIMC

Remarks: House Tios. MAY have changed 100%. Demi