


DATE _____

TOWN OF LEXINGTON — BOARD OF PUBLIC WORKS

WATER DIVISION

Sketch of Service Here
Concord Ave

429

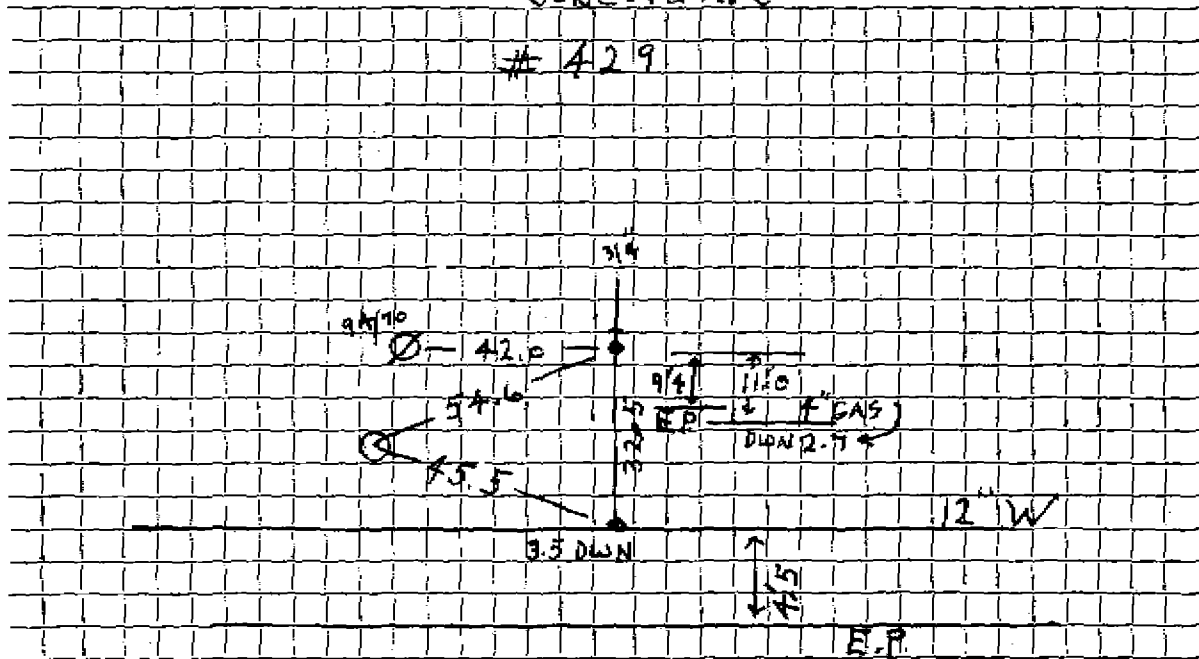

Connection made in Street. Work completed 2002 Demol

Remarks: 6" Water A.B. 2002 Demol