

WATER SERVICE RECORD

Name Soule Bros.

Service No. 18

Address 430 Concord Ave.

Location SELLARS HOUSE + BUILD.

~~Repair~~ Renewal ~~NEW SERVICE~~

JUL 24 1967

Date	Material	Amount	Total	Date	Amount	
6-12-67	Labor To House	341.81		5-8-67	Deposit	1500 00
	10% O.H.	34.18	375.99	7-24-67	Retaind	424 22
	510' 1" Copper Tubing @.99		504.90	10/19/61	35' 2" COPPER Tubing	10.25 28
	8 1" 3 part Unions		4.99		1 2" CORP COCK	
	1 1" I.W.H. Stop and Waste		9.70		1 2" ORISEAL CURB	
	1 1" Curb Cock		11.15		1 2" -C*I ADAPTER	
	1 1" 2 part Union		2.81		1 RD BOX	
	1 Box and Rod		5.10		1 12" X 2" SERVICE SADDLE	
	1 2" x 1" Iron Tee		3.50			
	2 2" G.L. Nipple		1.04		1 2" Style 38 CLAMP	
	2 2" Style 38 Repair Clamp		2.60		1 2" NIPPLE	
	19 hr. Shovel @6.50				1 M.H. FRAME + COVER	
	6 Hr. Trucking @ 3.00		18.00			
	3hrs. Loader @4.00		12.00	10/18/28	FROM PIT. To Build	
			1075.28	240'	2" C.L.P.	


TOWN OF LEXINGTON — BOARD OF PUBLIC WORKS

WATER DIVISION

DATE _____

Sketch of Service Here

Horse

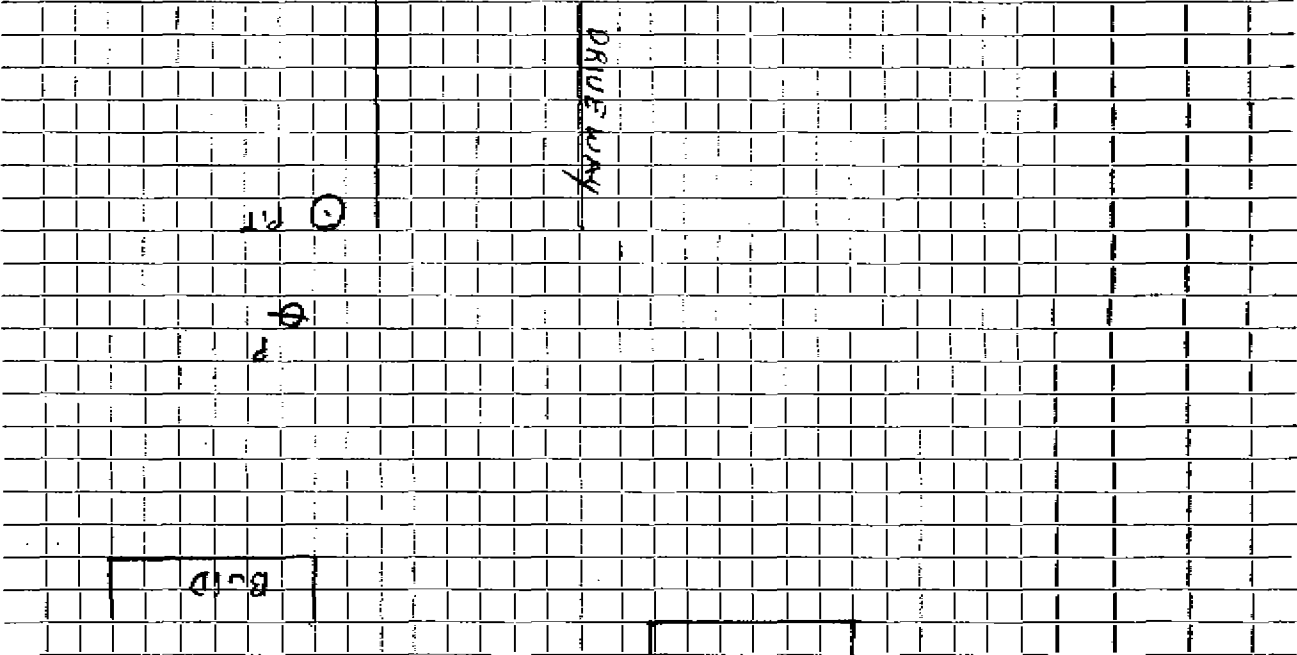

Connection made in _____

Street _____

Work completed _____

Remarks: _____

