


DATE _____

TOWN OF LEXINGTON — BOARD OF PUBLIC WORKS

WATER DIVISION

Sketch of Service Here
CONCORD AVE

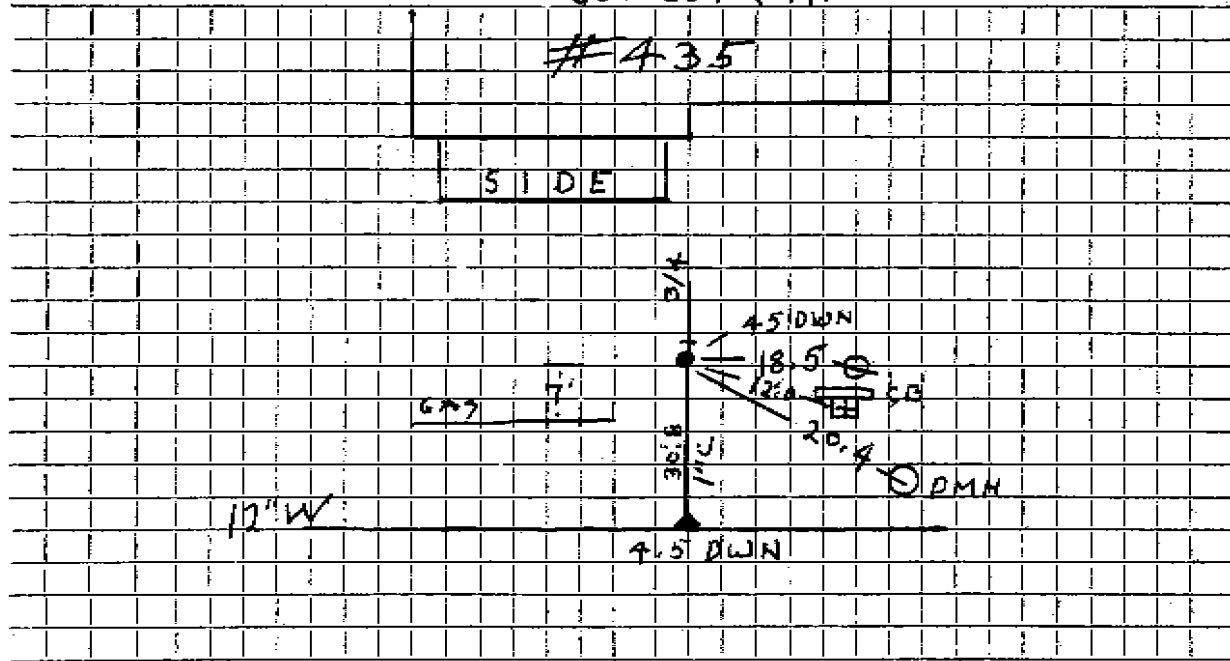

Connection made in Street. Work completed .. 2002 Sept .. Dimi Coroti

Remarks:
.....
.....