


DATE _____

TOWN OF LEXINGTON — BOARD OF PUBLIC WORKS
WATER DIVISION

Sketch of Service Here

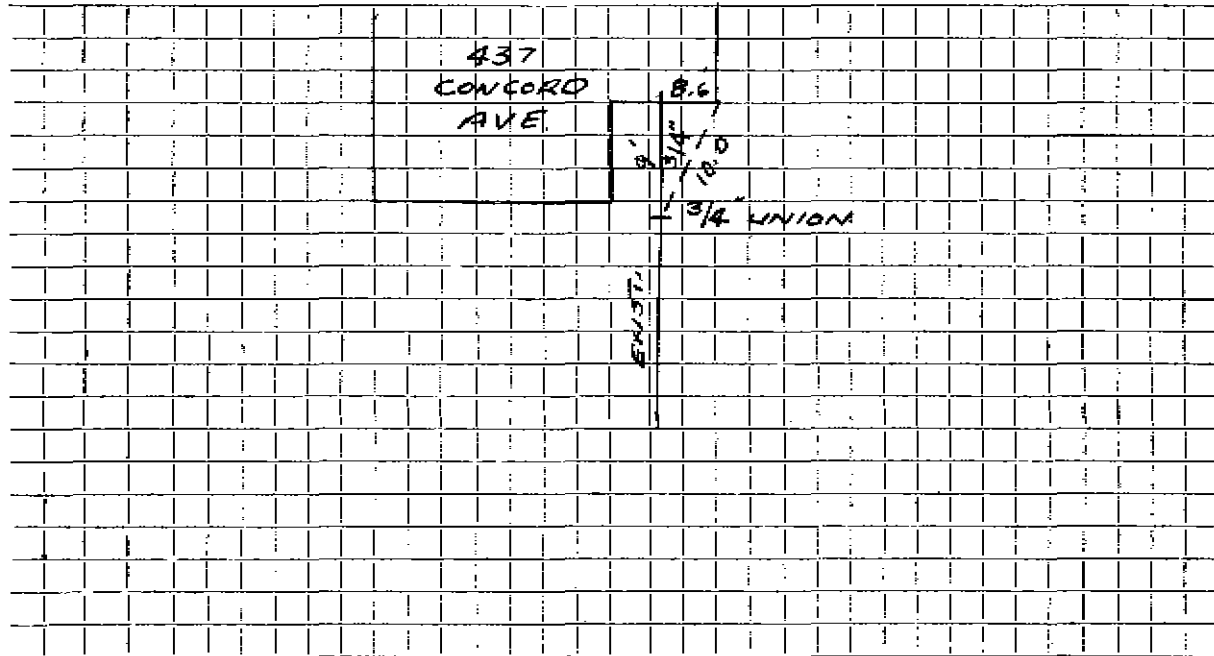

Connection made in CONCORD AVE. Street. Work completed

Remarks: PANDOLFO CO. INC.

NO PERMIT - BROKE LINE WHEN EXCA. FOR OIL STORAGE TANK