


DATE _____

TOWN OF LEXINGTON — BOARD OF PUBLIC WORKS

WATER DIVISION

Sketch of Service Here
CONCORD Ave

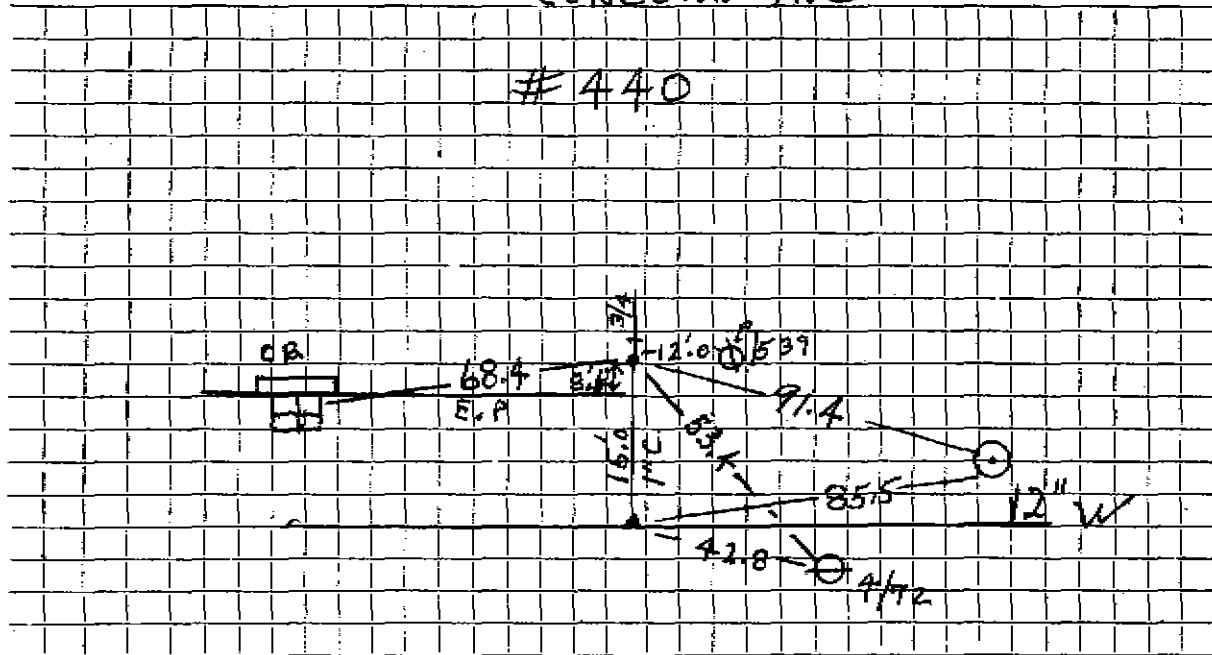

Connection made in Street. Work completed 2002 *Demé*

Remarks: *Curb 8'6" EDGS. PAVE.*