


DATE _____

TOWN OF LEXINGTON — BOARD OF PUBLIC WORKS

WATER DIVISION

447 CONCORD AVE

Sketch of Service Here

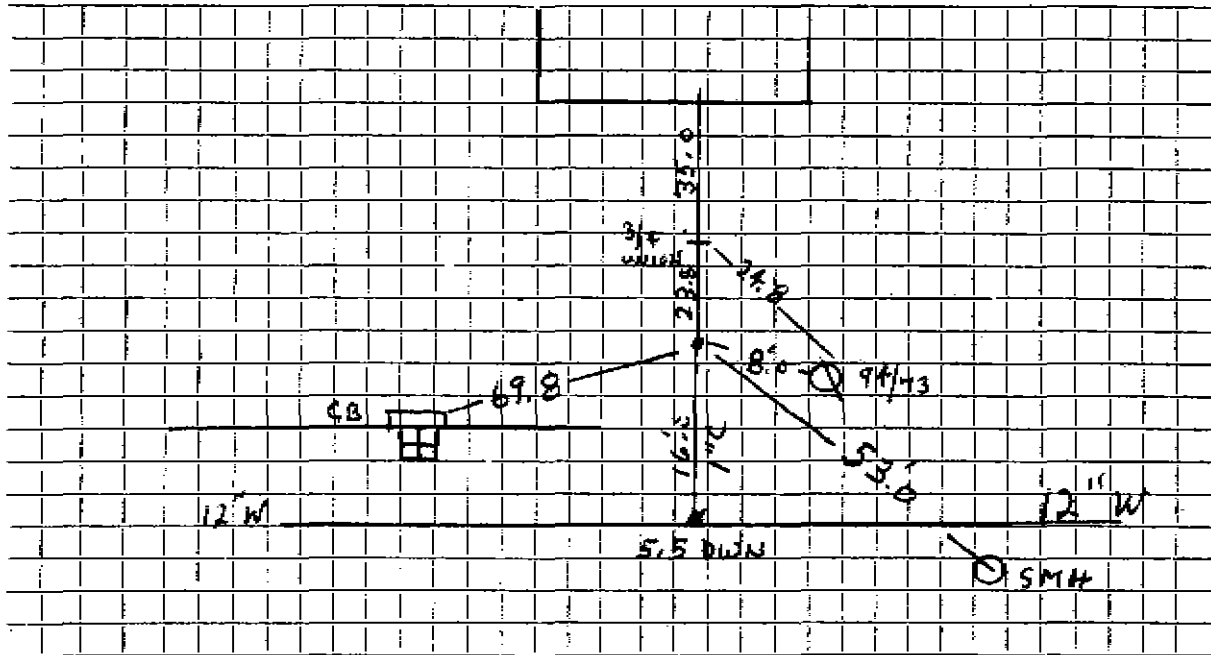

Connection made in Street. Work completed Aug 2002.....

Remarks: 6" A.B. 2002.....