

Name **D. J. Henley**
 Address **101 Hawthorne Road, Waltham, Mass.**
451 Concord Ave.

Service No. ~~#~~ **640**
#5417

Location **451 Concord Avenue**

Kind of Pipe _____ Size _____ Size of Main _____

Repair—Renewal—New Service _____ Location _____

Date 1940	Material	Amount	Total	Date	Amount
Oct. 22, <i>Com 11/18/40</i>	8 hrs. @ 60¢	4 80		October 1940 Deposited	25 00
	10% Overhead	48	5 28	November 25 1940 Returned	6 82
	55' 3/4" Copper tubing @ 18¢	9 90	9 90		
	1 3/4" C.xg I.S. & W.	2 25	2 25		
	1 hr. trucking @ 75¢	. 75	. 75		
			<u>18 18</u>		
	Labor				

Hadley Press, Inc., Lexington

DATE _____

TOWN OF LEXINGTON—BOARD OF PUBLIC WORKS

WATER DIVISION

The undersigned applies for a supply of water at No. 451 St. and hereby agrees to comply with the rules and regulations as now, or at any future time, established by the Board of Selectmen.

Am't. of Estimate \$ _____


Owner Gough

Am't. Paid \$ _____

Address 451 Concord Ave

Builder L J Henley Henley
101 Hawthorn Rd Waltham

Sketch of Service Here

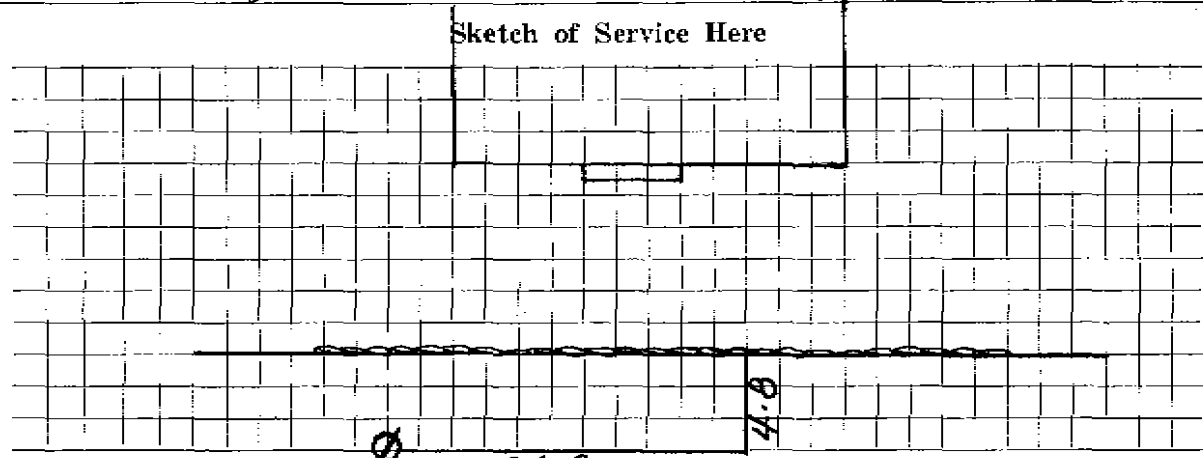

Connection made in _____ Street.

Work completed _____ 19__

Remarks: