

WATER SERVICE RECORD

Name

Service No. 641

Address 461-463 CONCORD AVE

Location

Repair—Renewal—New Service

Date	Material	Amount	Total	Date	Demt 2002	Amount
6/3/68 ?				AUG 01 22.5	1" Copper	
54	1" Copper				1" Corp	
	1" X 3/4 S + W				1" CURB STOP	
					<del>buff to box ?</del>	
					Box + Rod	
				5/10/65	1 1/4" CLAMP	
					<del>SPLIT PIPE</del>	


DATE \_\_\_\_\_

TOWN OF LEXINGTON — BOARD OF PUBLIC WORKS

WATER DIVISION

461 CONCORD AVE

Sketch of Service Here

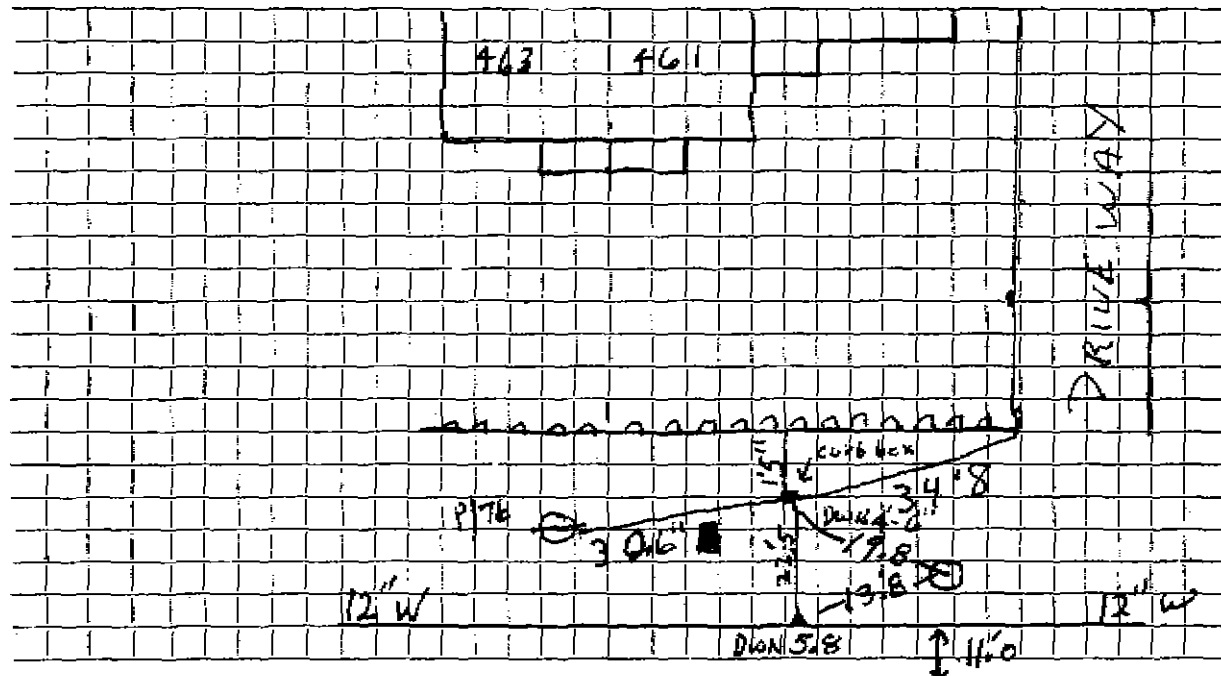

Connection made in ..... Street. Work completed ..... E.P. ....

Remarks: .....  
.....  
.....