


DATE _____

TOWN OF LEXINGTON — BOARD OF PUBLIC WORKS
WATER DIVISION

Sketch of Service Here
464 CONCORD AVE

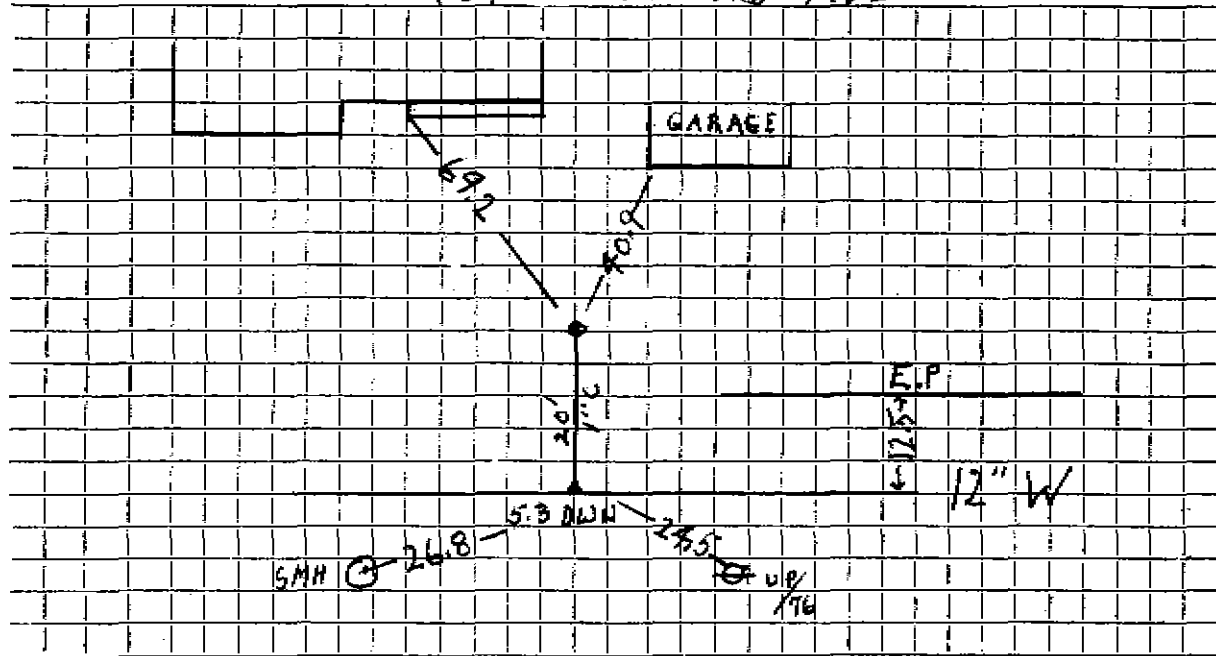

Connection made in Street. Work completed .. 2002

Remarks:
.....
.....

WATER SERVICE RECORD

Name Moore Construction Co.

Service No. 217

Address 464 Concord Avenue

Location Lexington

Repair/Replacement - New Service

Com. 11-24-52


Date	Material	Amount	Total	Date	Amount
10/27/52	Labor	6 38		9-15-52	Deposited 25
	10% overhead	64	7 02	11-24-52	Refunded 5 35
	74' - 3/4" copper tubing@	.34	25 16		<u>NON CHARGE</u> 69 65
	1 -3/4" C x 1/2 I.W.H. stop& waste		4 00	10/27/52	Labor 14 20
	1 -3/4" C x 3/4" C. union		1 72	34' - 3/4" copper tubing@ .34	11 56
	2 hrs. Littlefield shovel		14 00	1 -3/4" C. corp-cock	4 33
	1 hr. trucking		75	1 -3/4" C x 1/4" C. curb-cock	4 67
	patching 17 x 3		17 00	1 box and rod	3 90
			69 65	1 -1/2 offset tail pc.	50
				1 -1/2 straight tail pc.	50
				2 hrs. Littlefield shovel	14 00
				1 hr. trucking	75
				Service broken by Cont.	54 41
				9/22/61 10' 3/4 COPPER	
				1 3/4 3PART union	
				1 88 Union	
				1 3/4 Curb Cock	

DATE _____

TOWN OF LEXINGTON — BOARD OF PUBLIC WORKS

WATER DIVISION

Sketch of Service Here

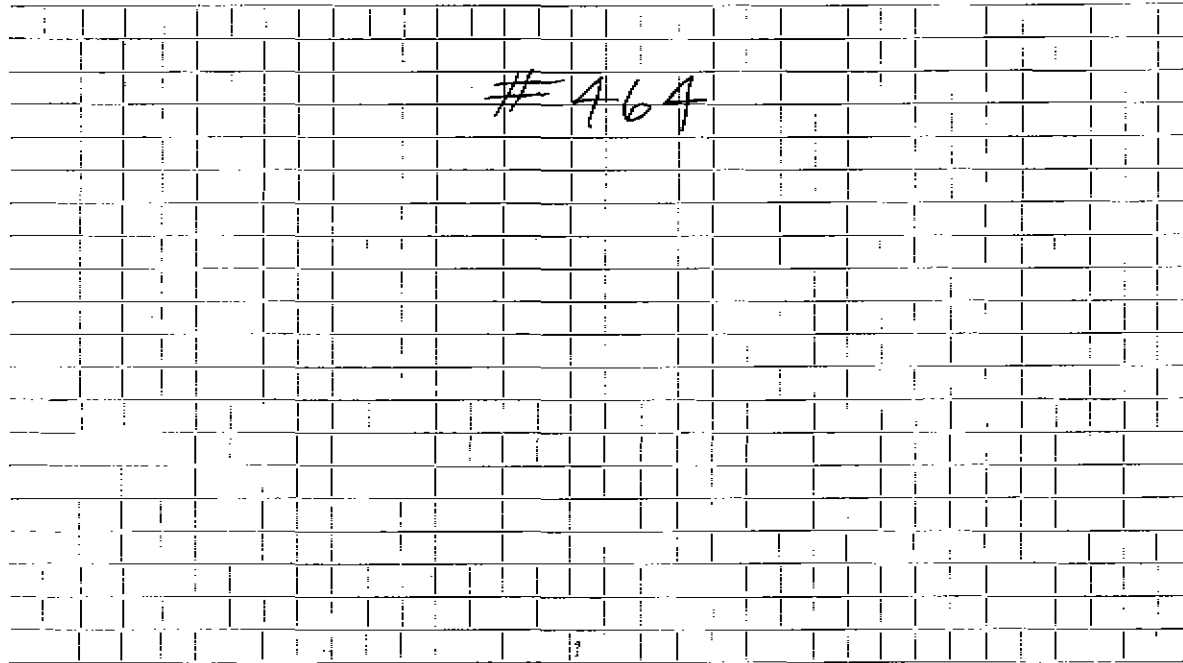

Connection made in Street. Work completed

Remarks:

.....

.....