

WATER SERVICE RECORD

Name Herbert Eisenberg

Service No. 276

Address 470 Concord Ave.

#4598, 4599

Location

~~Repair~~ ~~Renewal~~ - New Service


Comm. 3-3-58

Date	Material	Amount	Total	Date	Amount
12/10/57	Labor	27 14		11-22-57	Deposit # 150 00
	10% overhead	<u>2 71</u>		3-3-58	Refund 71 35
			29 85		78 65
	82' 3/4" copper tubing @ .37	30 34			NON CHARGE
	1 3/4" Cx 1/2 IWH stop & waste	4 96			labor 3 59
	1 hr. trucking @ .75	75			10' 3/4" copper tubing 3 70
	1 1/2 hr. town shovel @ 6.50	9 75			1 3/4" C corp cock 4 64
	3 x 3 Patch	3 00			1 3/4" C curb cock 5 94
			78 65		1 box & rod 4 62
					1 1/2 straight tail pc. 50
					1 1/2 offset tail pc. 50
					1 1/2 hr. town shovel @ 6.50 9 75
					1 hr trucking @ .75 75
					<u>33 99</u>

DATE _____

TOWN OF LEXINGTON — BOARD OF PUBLIC WORKS
WATER DIVISION

Sketch of Service Here

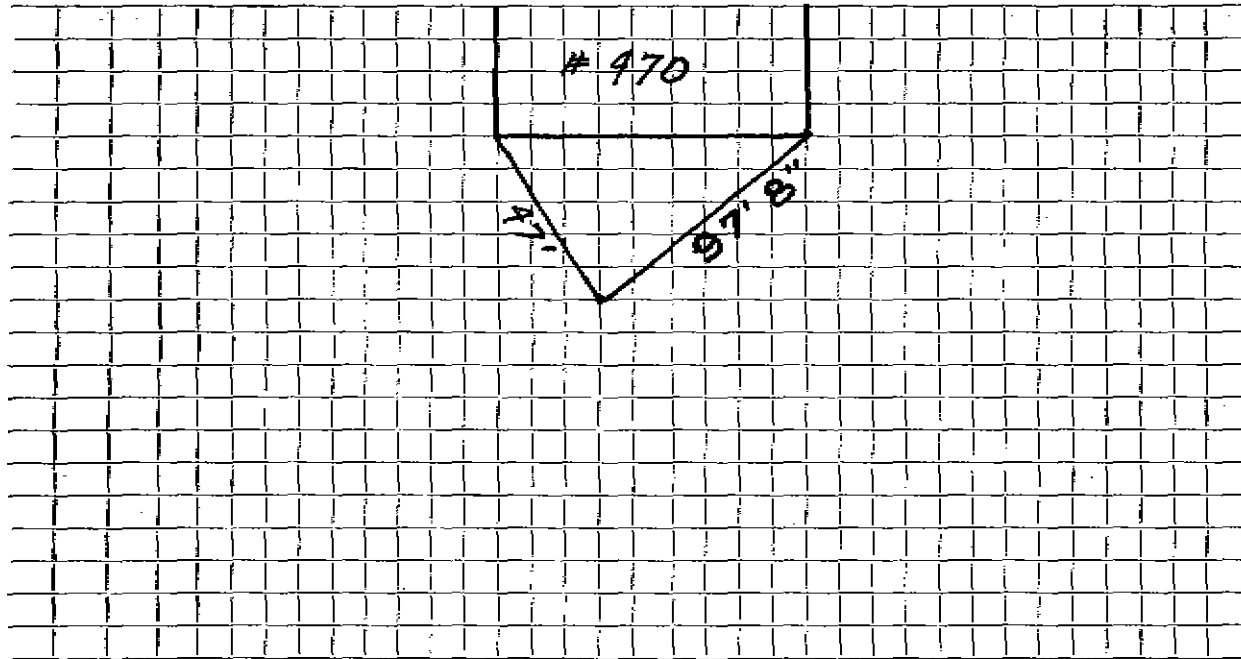

Connection made in Street. Work completed

Remarks:
.....
.....