

Name Michael J. McCormack

Service No. 68 C 44

Address 475 Concord Avenue

# 6674

Lexington, Mass.

Location 475 Concord Avenue

Kind of Pipe

Size

Size of Main

~~Repair~~—Renewal—~~New Service~~

Location

Date	Material	Amount	Total	Date	Amount
July 23, '46	Labor	31 28	31 28	July 22, '46	60 00
	10% overhead		3 13		11 42
	50' - 1/2" Copper Tubing #.1911	9 56			48 68
	1 - 1/2" C x 3/4" r.w.n. stop & waste	3 82		July 25, '46	7 20
	1 - 1/2" C x 3/4" Union (3 parts)	1 04			1 34
	Trucking 1 hr. @ .75		75		3 30
			48 58		1 18
					75
					13 77
				Aug 02 29'	1" Copper
					1" Corp
					1" Coub
					1x 3/4 Red
					bufflo box
	Labor				

Deposited  
function  
Non-Charge

~~July 25, '46 Labor  
7' - 1/2" Copper Tubing #.1911  
1 - 1/2" C x 3/4" C Carb-cock  
1 - 1/2" Copper adapter  
Trucking 1 hr. @ .75~~

Hadley Press, Inc., Lexington

DATE \_\_\_\_\_

# TOWN OF LEXINGTON - BOARD OF PUBLIC WORKS WATER DIVISION

The undersigned applies for a supply of water at No. \_\_\_\_\_ St. and hereby agrees to comply with the rules and regulations as now, or at any future time, established by the Board of Selectmen.


Am't. of Estimate \$ \_\_\_\_\_

Owner \_\_\_\_\_

Am't. Paid \$ \_\_\_\_\_

Address \_\_\_\_\_

Builder \_\_\_\_\_

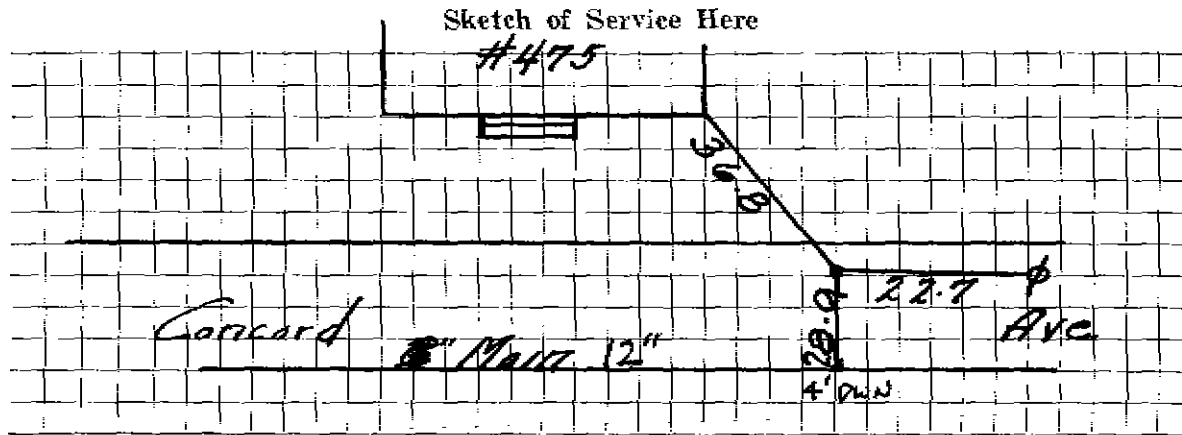

Connection made in \_\_\_\_\_ Street.

Work completed DEM 2002 10

Remarks: Tie's MAY have changed FROM house 62