


DATE _____

TOWN OF LEXINGTON — BOARD OF PUBLIC WORKS

WATER DIVISION

Sketch of Service Here
501

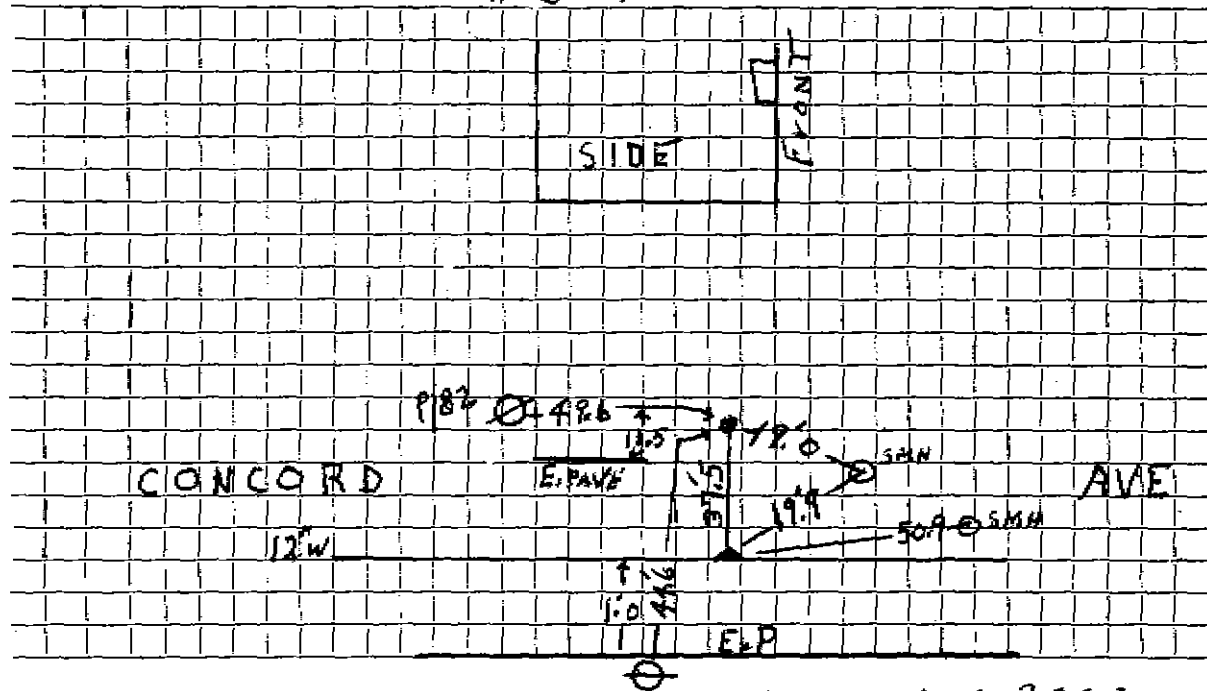

Connection made in Street. Work completed AUG. 2002.....

Remarks:
.....
.....