

## WATER SERVICE RECORD

Name H. Morse Payne

Service No. 261

Address 502 Concord Ave., Lexington, Mass.

# 1747 \*

Location

~~Repair Account~~ - New Service

Comm. 12/31/57


Date	Material	Amount	Total	Date	Amount
11/30/57	Labor	10 56		11-8-57	Deposit \$ 75 00
	10% Overhead	1 06	11 62	12-31-57	Refund 20 32
	84'-3/4" Copper Tubing @.37		31 08		\$ 54 68
	1-3/4" C x 1/2 IWH stop & waste		4 96		Non Charge
	1-3/4" C-3 part union		2 27		Labor 39 77
	1 hr. trucking @.75		75		10'-3/4" Copper tubing @.37 3 70
	4 x 3 patch		4 00		1-3/4" C Corp cock 5 64
			54 68		1-3/4" C Curb cock 5 94
					1 Bow & Rod 4 62
					1-1/2 straight tailpiece 50
					2 hrs. Town Shovel @ 6.50-13 00
					72 17

DATE \_\_\_\_\_

TOWN OF LEXINGTON — BOARD OF PUBLIC WORKS

WATER DIVISION

Sketch of Service Here

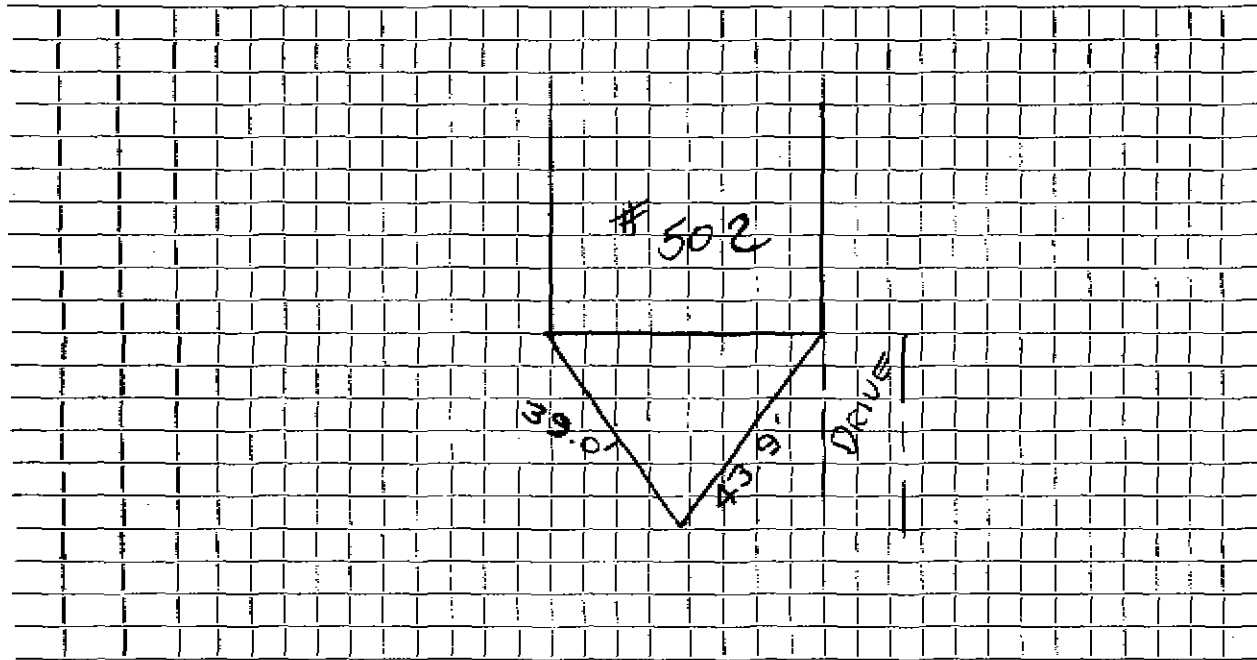

Connection made in \_\_\_\_\_ Street. Work completed \_\_\_\_\_

Remarks: \_\_\_\_\_  
\_\_\_\_\_  
\_\_\_\_\_